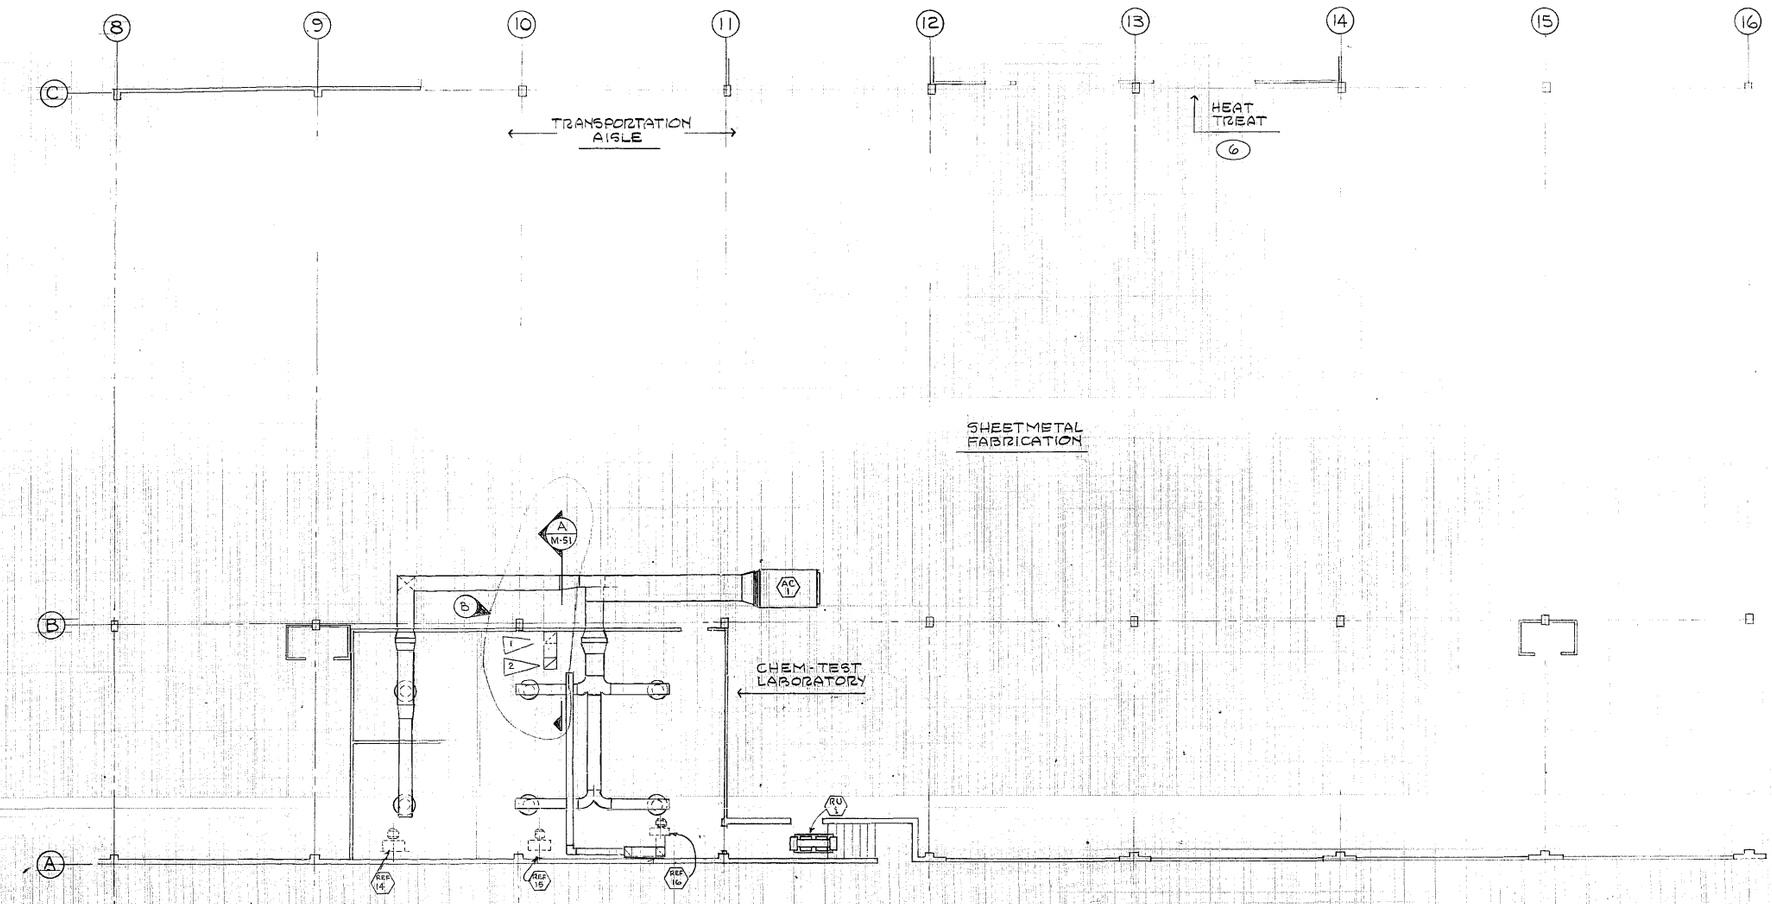

PARTIAL FIRST FLOOR PLAN
SCALE: 1/8"=1'-0"

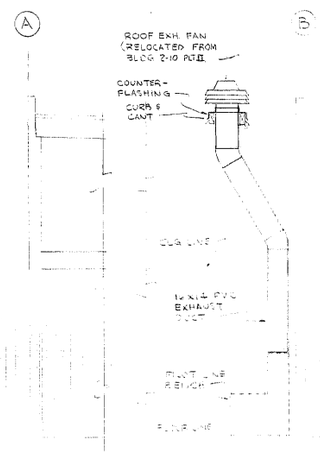

A M-51 SECTION
SCALE 1/4

FLAG NOTES

1. 16"x14" PVC DUCT UP FROM PILOT LINE BENCH
2. 16"x16" PVC. DUCT UP THRU ROOF TO ROOF EXHAUST FAN. OFFSET DUCT ABOVE FURRED CEILING AS SHOWN

GRAPHIC SCALES

1 1/2" = 3"
1/2" = 1"
3/8" = 3/4"
1/8" = 1/4"

897187

24X -- DO NOT SCALE

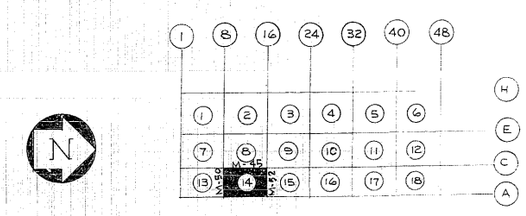

KEY PLAN BLDG. 12.02
FORMER NO. 1812-02-4157

SYM.	REVISION	BY	APPROVED	DATE
B	ADDED ROOF EXHAUST FAN FOR PILOT LINE BENCH	RWP		
A	AS BUILT	EIS'	RWP	3/15/68

ENGINEERED INDUSTRIAL SYSTEMS INC
CONSULTING ENGINEERS
SEATTLE WASHINGTON

ENGINEERED INDUSTRIAL SYSTEMS INC. STATE OF WASHINGTON REGISTERED PROFESSIONAL ENGINEER

		DATE
DRAWN BY	EISI	
CHECKED	GHT	
CHECKED		
APPROVED		
APPROVED		
APPROVED		

SUB TITLE: FLOOR PLAN - VENTILATION
TITLE: MECHANICAL MASTER
COL. A-C, 8-16 BLDG. 12.02

SHEET M-51 OF
ISSUE B
JOB NO. 2967
DWG. NO. 1812-02-4157

WA0954KC
1410

AF 4-12-68