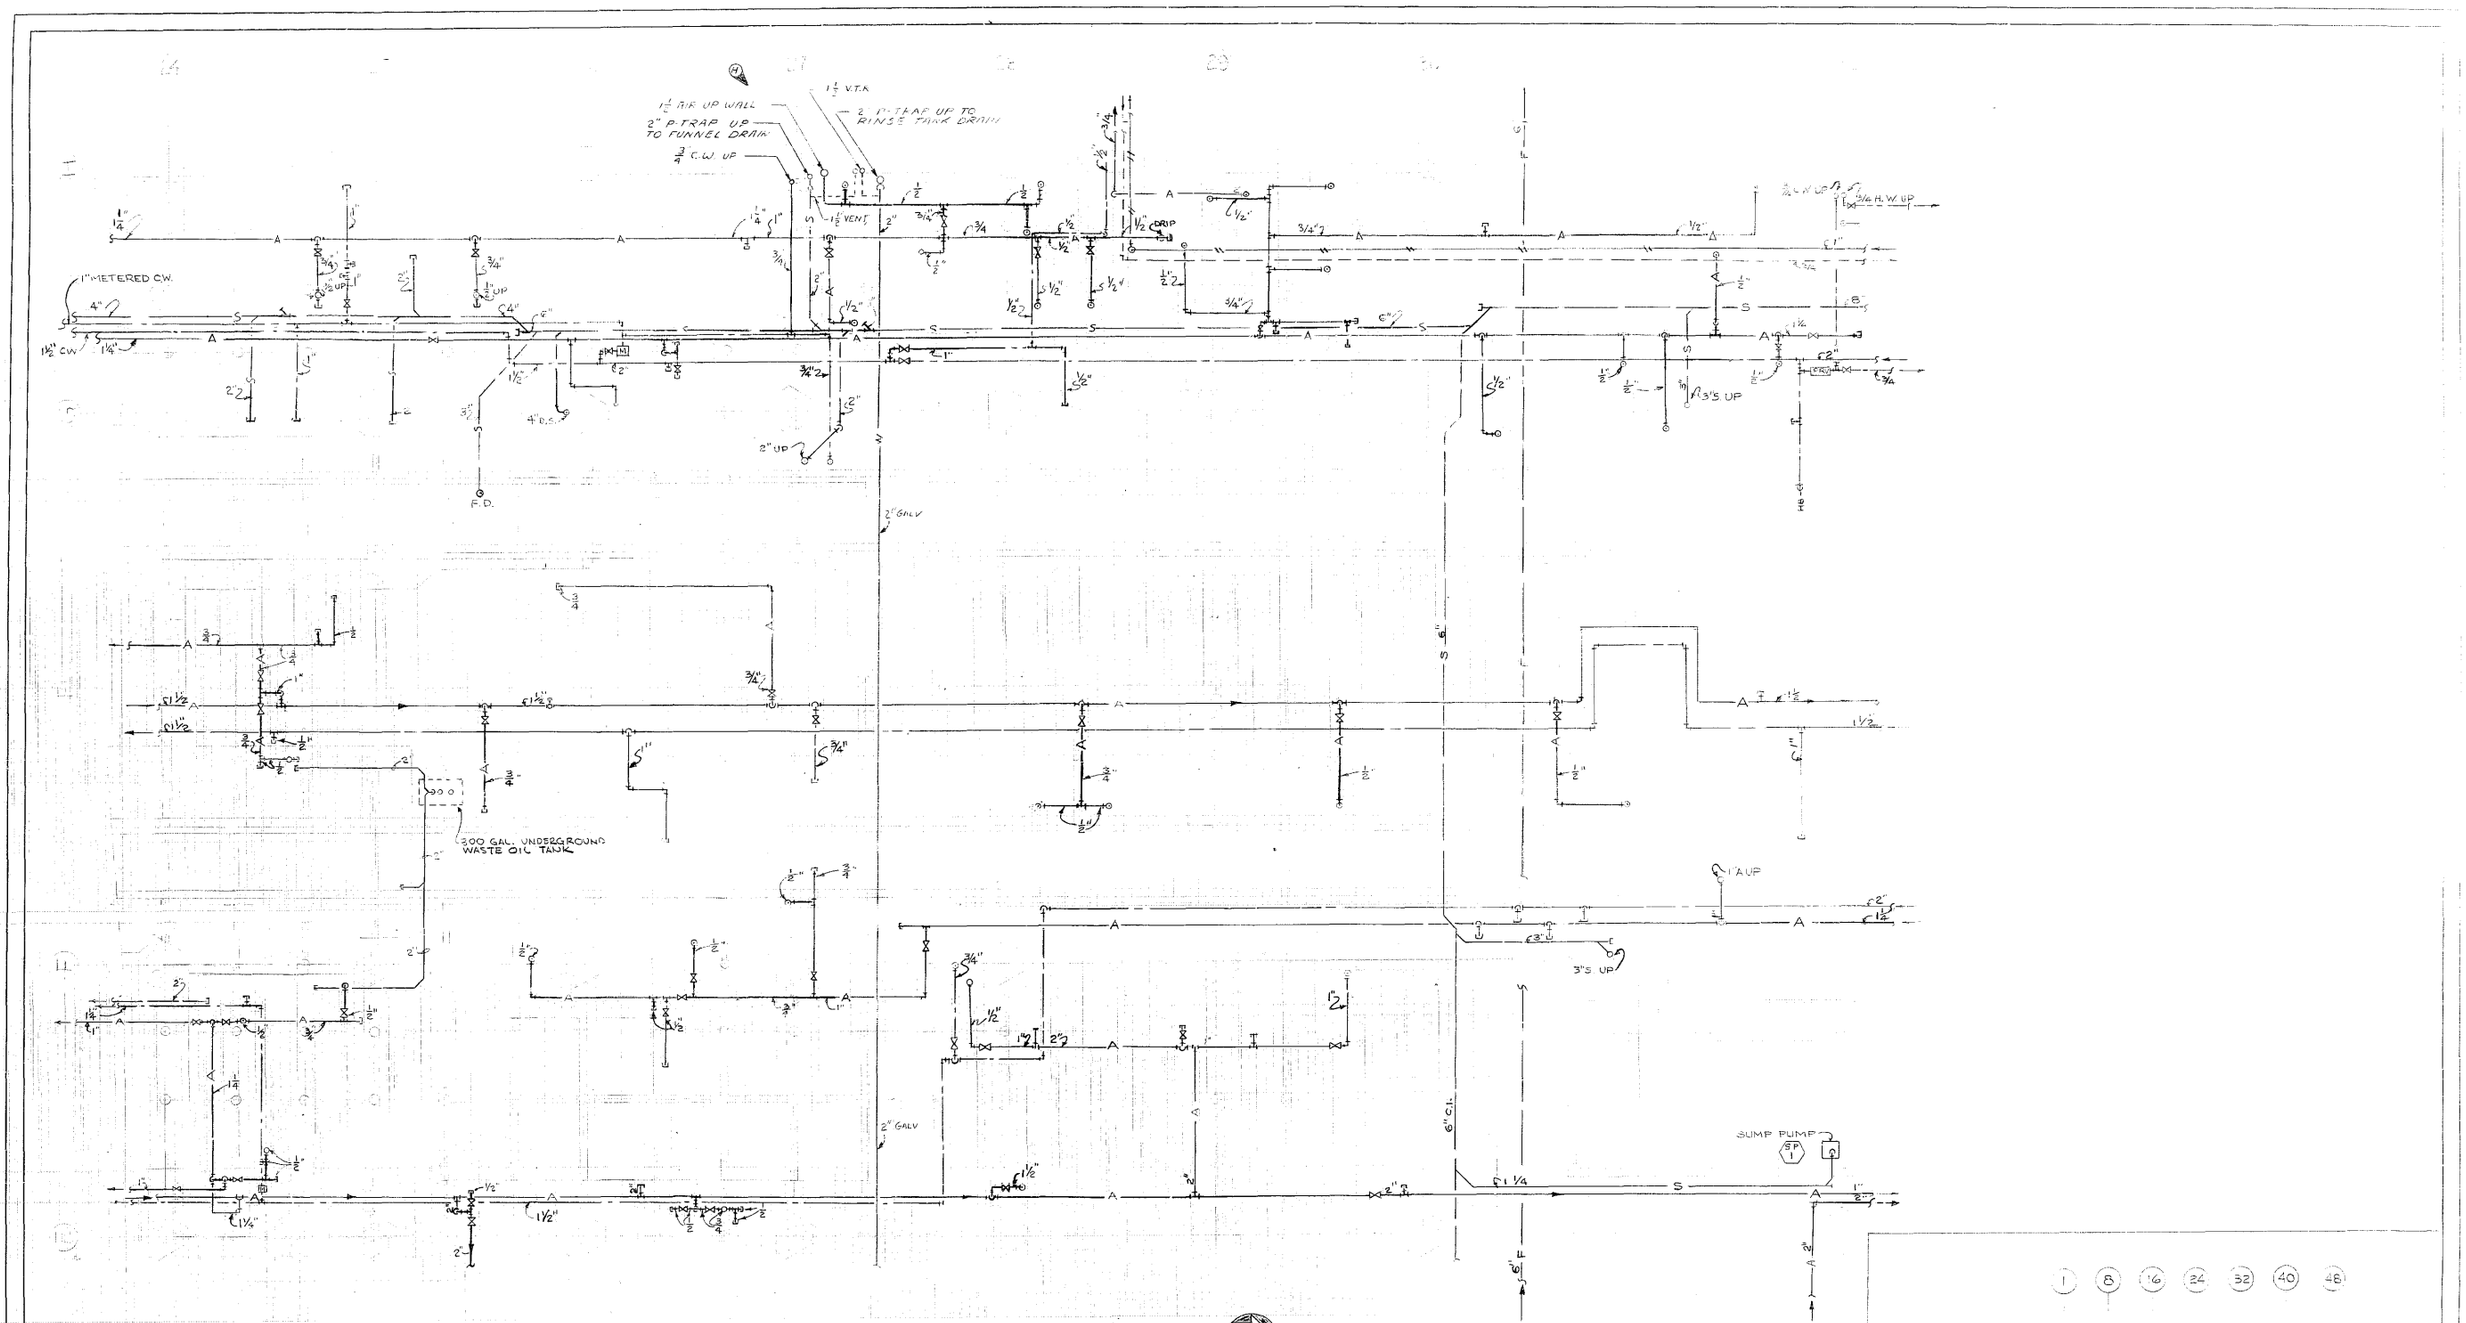

FOUNDATION & CRAWL SPACE PLAN

SCALE: ⅛"=1'-0"

GRAPHIC SCALES

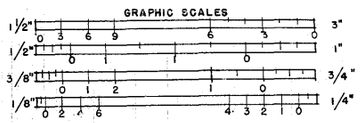

897190

24X -- DO NOT SCALE

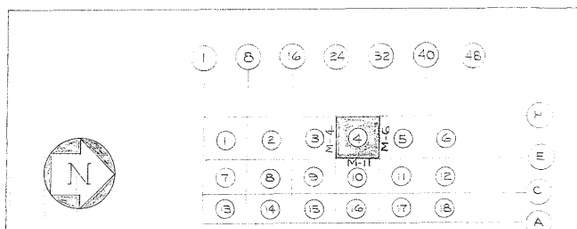

KEY PLAN BLDG. 12.02

SYM.	REVISION	BY	APPROVED	DATE
H	ADDED AIR, WATER, & DRAINS TO INDUCTION BRAZE AREA	BENZE		5/20/68
G	AS BUILT	EISI	RWP	5/15/68
F	REVISED PIPING	EISI	RWP	11/27/67

SYM.	REVISION	BY	APPROVED	DATE
E	ADDED WASTE OIL TANK	EISI	RWP	11/2/67
D	REVISED AIR PIPING	EISI	RWP	10/25/67
C	ISSUED FOR PHASE II	EISI	G.H.T.	9/25/67
B	ISSUED FOR CONSTRUCTION	EISI	GHT	9/1/67
A	ISSUED FOR BID-CONTRACT ASD (FAC) 67-28	EISI	GHT	6/12/67

ENGINEERED INDUSTRIAL SYSTEMS INC

CONSULTING ENGINEERS

SEATTLE WASHINGTON

		DATE
DRAWN BY	EISI	6/1/67
CHECKED	G.H.T.	6/9/67
CHECKED		
APPROVED		
APPROVED		
APPROVED		

SUB TITLE: FOUNDATION PLAN

TITLE: MECHANICAL MASTER

COL. E-H, 24-32 BLDG. 12.02

SHEET M-5 OF

JOB NO. 67-67

DWG. NO. 12-002-41-7

ISSUE G

WA09 54KC

13