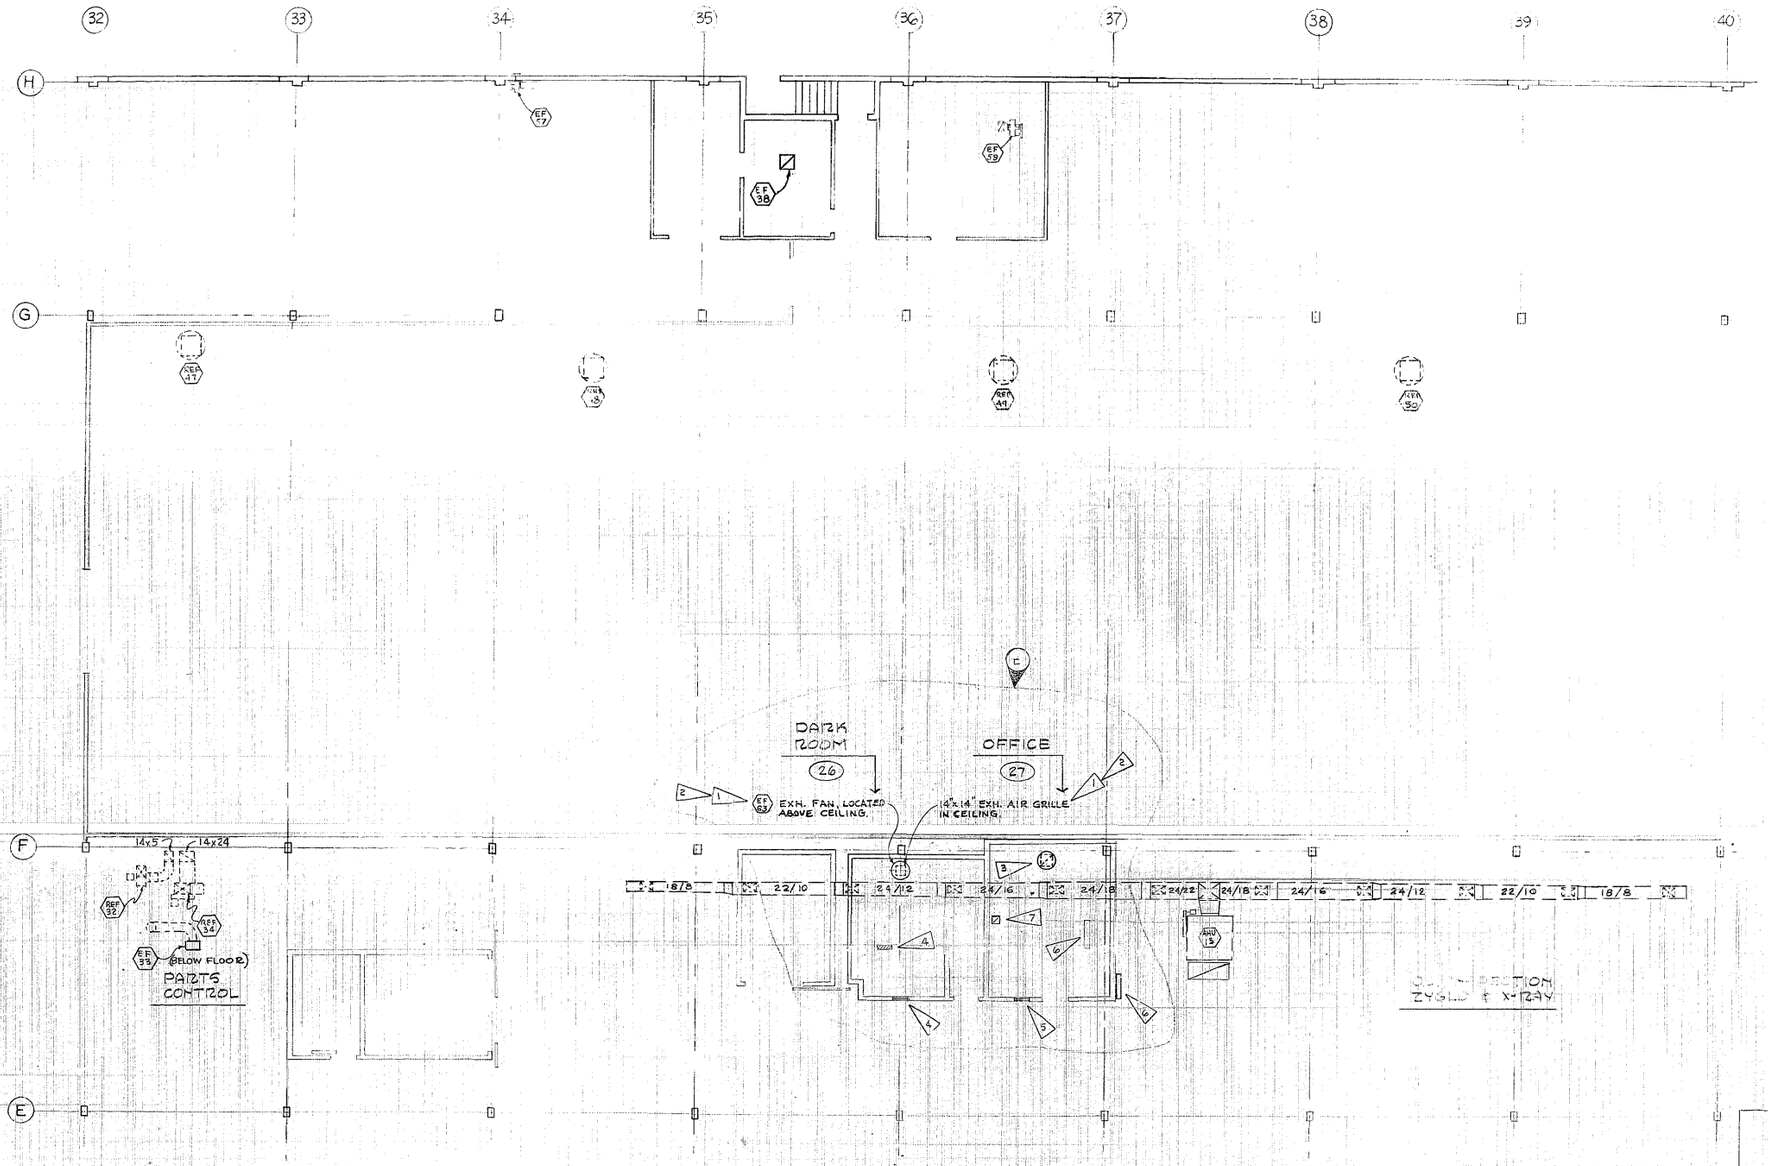

PARTIAL FIRST FLOOR PLAN

SCALE 1/8" = 1'-0"

FLAG NOTES

1. REMOVE EXISTING DARK ROOM ROOF EXHAUST FAN & 14"X14" EXHAUST AIR GRILLE.
2. REINSTALL 14"X14" EXHAUST AIR GRILLE IN NEW [illegible] CEILING. PROVIDE & INSTALL NEW JENN AIR MODEL [illegible] ROOF EXHAUST FAN, 345 CFM @ 1/4" SP, 860 RPM, 1/2 HP 120 V., 1 PH. COMPLETE WITH BACKDRAFT DAMPER.
3. PROVIDE & INSTALL NEW JENN AIR MODEL 108 CR ROOF EXHAUST FAN, 345 CFM @ 1/4" SP, 860 RPM, 1/2 HP, 120V 1PH, COMPLETE WITH BACKDRAFT DAMPER, 14"X14" EXHAUST AIR GRILLE, T&B T980WL, LIGHTPROOF, DEAD BLACK FINISH.
4. REMOVE EXIST. 20"X16" AIR RELIEF GRILLE IN EXIST DARK ROOM WALL & RE-INSTALL IN NEW DARK ROOM WALL
5. PROVIDE NEW 20"X16" AIR RELIEF GRILLE WITH 1" THICK THROWAWAY TYPE FIBERGLASS FILTER & FRAME. INSTALL NEAR CEILING. GRILLE TO BE T&B T980WL, LIGHTPROOF, DEAD BLACK FINISH.
6. RELOCATE EXIST. AHU 13 CONTROL PANEL.
7. 10"X10" DUCT THRU CEILING FROM FILM DRYER

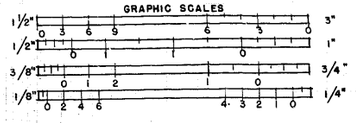

897192

24X -- DO NOT SCALE

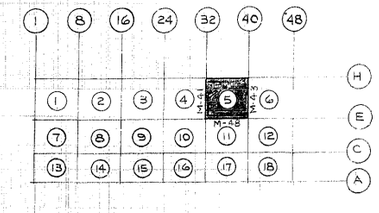

KEY PLAN BLDG. 12.02

FORMER NO. 1512-02-4157

SYM.	REVISION	BY	APPROVED	DATE
E	REVISED DARK ROOM, ADDED INTERPRETATION ROOM	RWP	K.KINZER FOR J.A.	8-7-68
D	AS BUILT	EISI	RWP	3/15/68
C	ISSUED FOR PHASE II	EISI	GHT	9/25/67
B	ISSUED FOR CONSTRUCTION	EISI	GHT	9/1/67
A	ISSUED FOR BID-CONTRACT ASD (FAC) 67-28	EISI	GHT	6/12/67

ENGINEERED INDUSTRIAL SYSTEMS INC

CONSULTING ENGINEERS

SEATTLE WASHINGTON

DRAWN BY	EISI	DATE 6/1/67
CHECKED	GHT	6/9/67
CHECKED		
APPROVED		
APPROVED		
APPROVED		

SUB TITLE: FLOOR PLAN-VENTILATION

TITLE: MECHANICAL MASTER

COL. E-H, 32-40 BLDG. 12.02

SHEET M-42 OF

ISSUE

JOB NO. 2957

DWG. NO. 812-02-4157

WA0954KC

1400