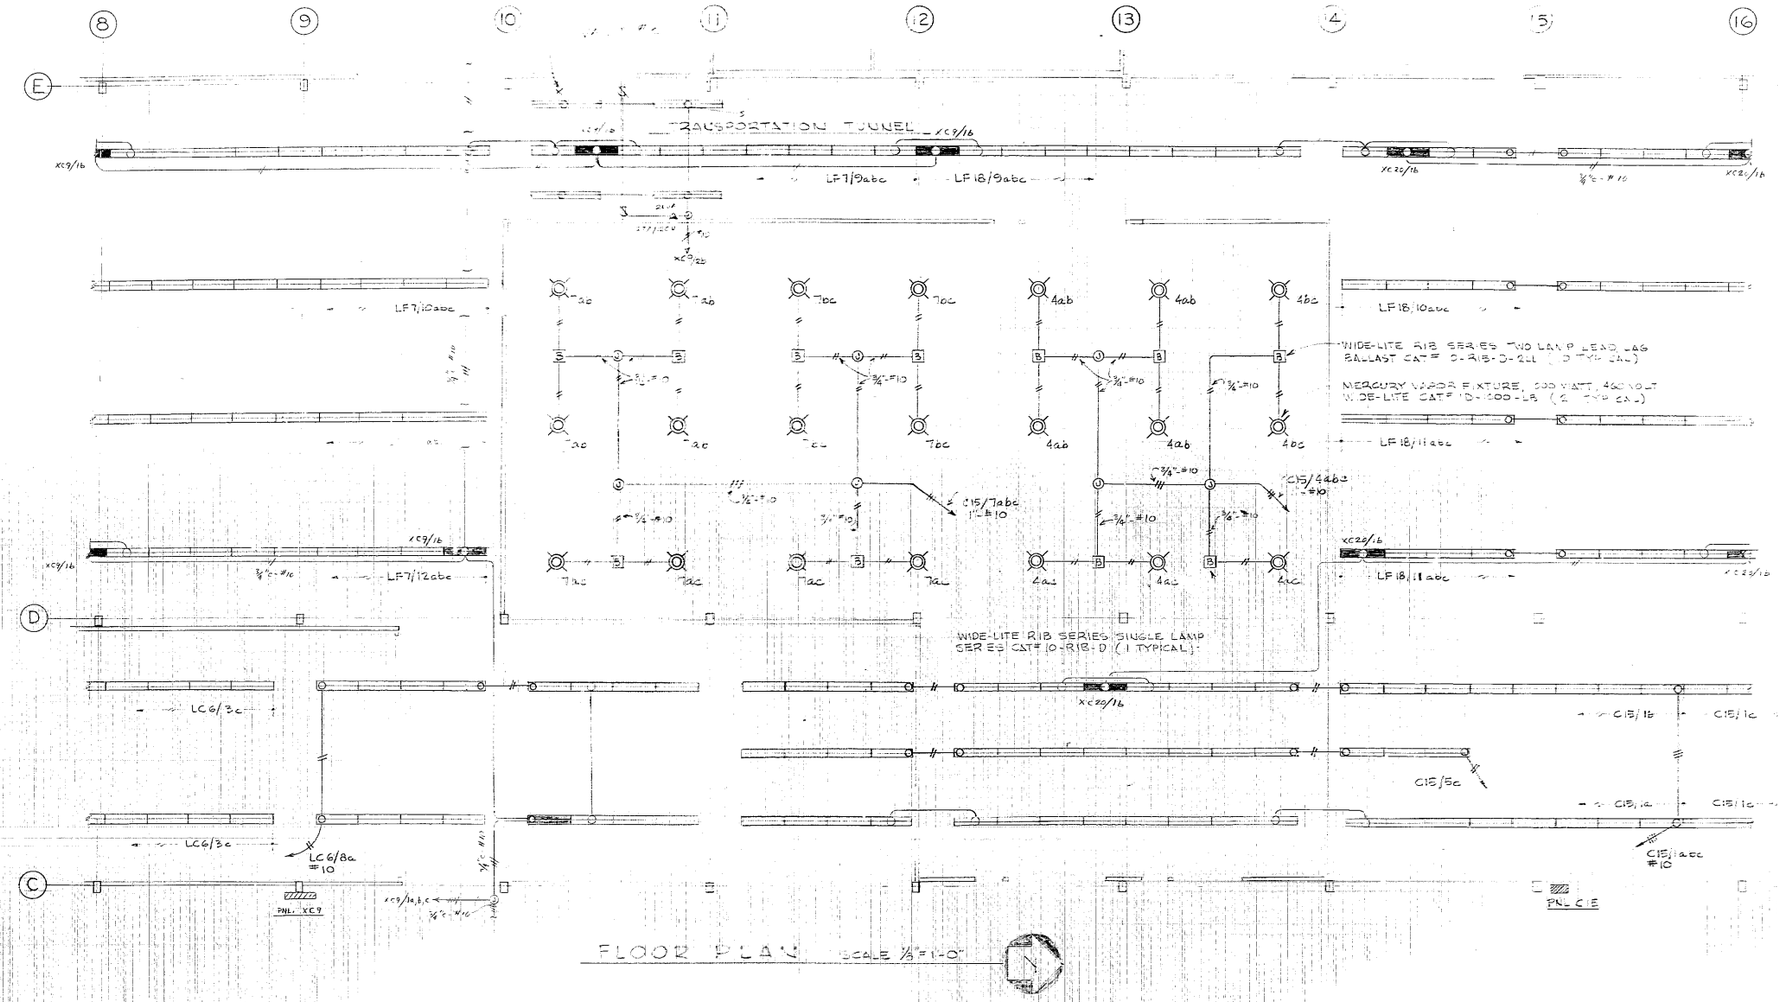


FLOOR PLAN SCALE 1/8"=1'-0"

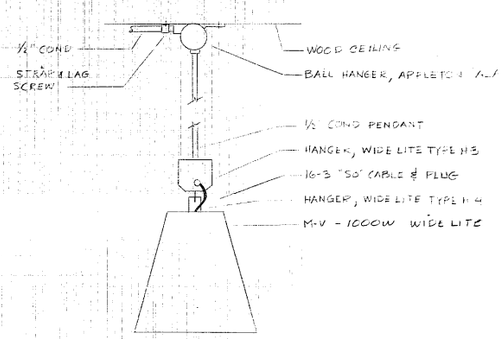


GRAPHIC SCALES

897195

24X -- DO NOT SCALE

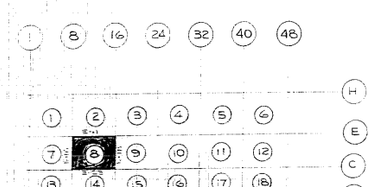

KEY PLAN BLDG 12 02

| SYM. | REVISION | BY | APPROVED | DATE |
|---|---|---|---|---|
| | | | | |

| SYM. | REVISION | BY | APPROVED | DATE |
|---|---|---|---|---|
| E | INSTALL EGRESS LIGHTING #174025-67 | PLM | [illegible] | 5-22-68 |
| D | AS BUILT | EISI | EWC | 3/15/68 |
| C | ADDED SUPPLEMENTARY LIGHTING IN TOOL CRIB | EISI | EWC | 11/4/67 |
| B | ISSUED FOR CONSTRUCTION | EISI | EWC | 2/1/67 |
| A | ISSUED FOR B.D-CONTRACT ASD (FAC) 67-28 | EISI | EWC | 6/2/67 |

**ENGINEERED INDUSTRIAL SYSTEMS INC**
CONSULTING ENGINEERS
SEATTLE WASHINGTON

ENGINEERED INDUSTRIAL SYSTEMS STATE OF WASHINGTON REGISTERED PROFESSIONAL ENGINEER

| | | |
|---|---|---|
| DRAWN BY | DAR/JAA | DATE 3-31-67 |
| CHECKED | RLW | 6/8/67 |
| CHECKED | | |
| APPROVED | | |
| APPROVED | | |
| APPROVED | | |

SUB TITLE: LIGHTING

TITLE: ELECTRICAL MASTER

COL. C-E, 8-16 BLDG 2 02

SHEET E-17 OF

JOB NO. 2-86

DWG. NO. 3-2005-2-02-E-17

ISSUE D

NA0954KL