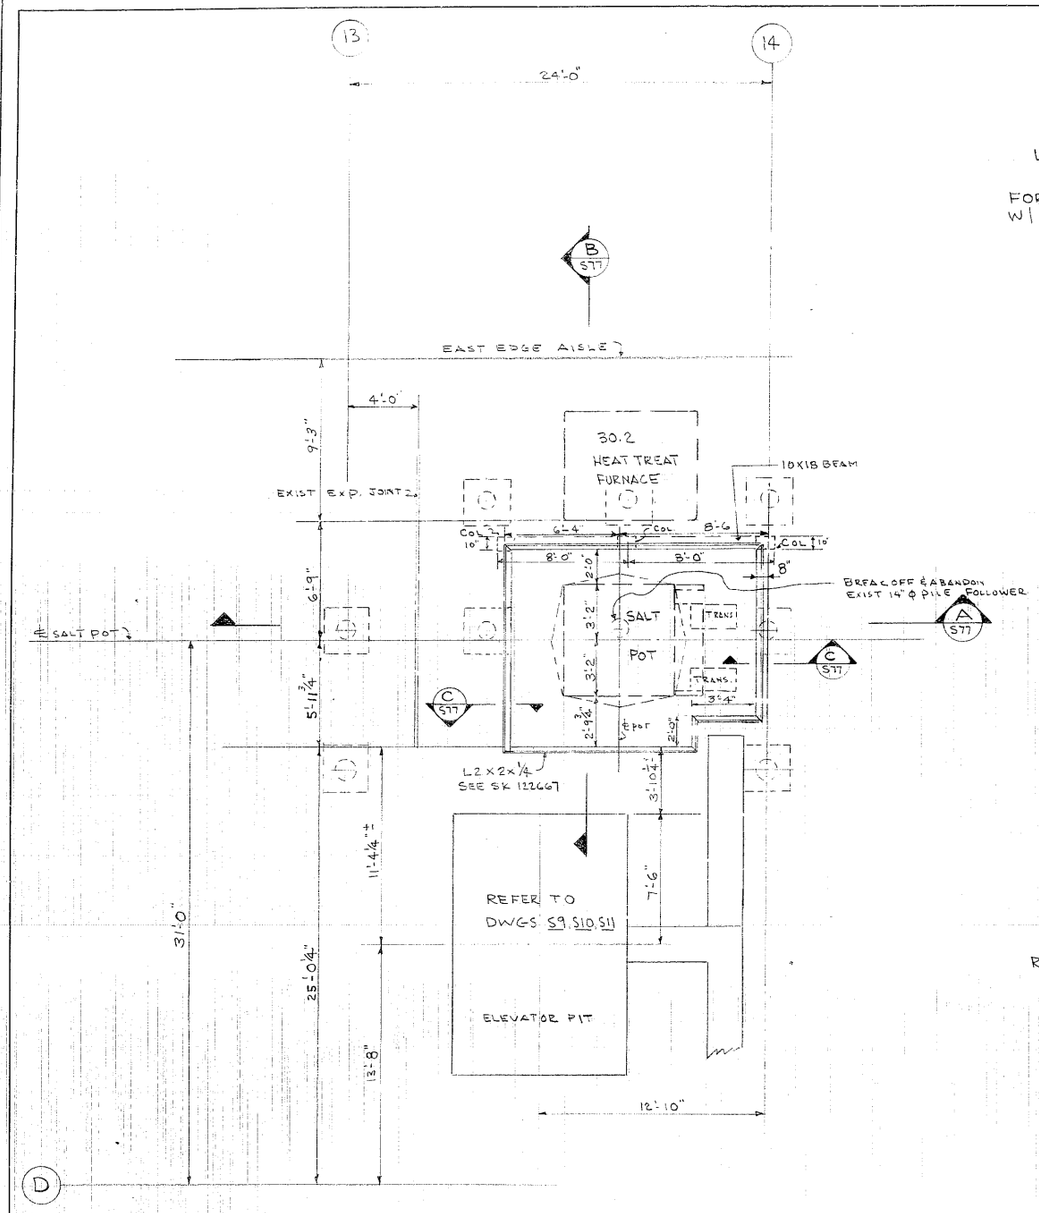

PLAN @ SALT POT PIT AREA
SCALE 1/4" = 1'-0"

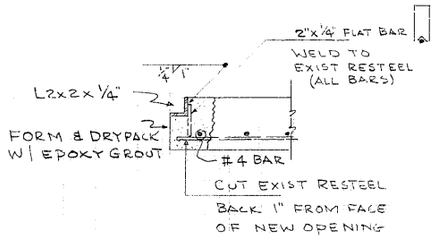

C S77 SECTION
1½" = 1'-0"

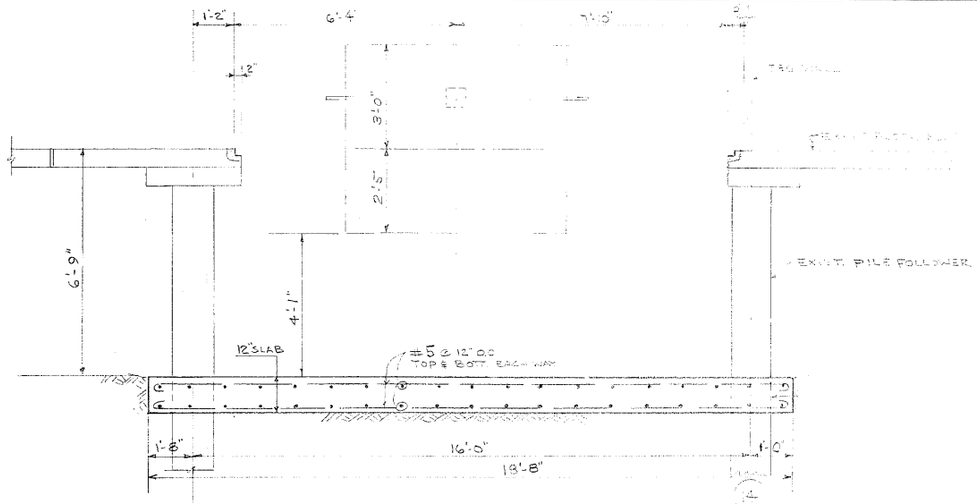

A S77 SECTION
½" = 1'-0"

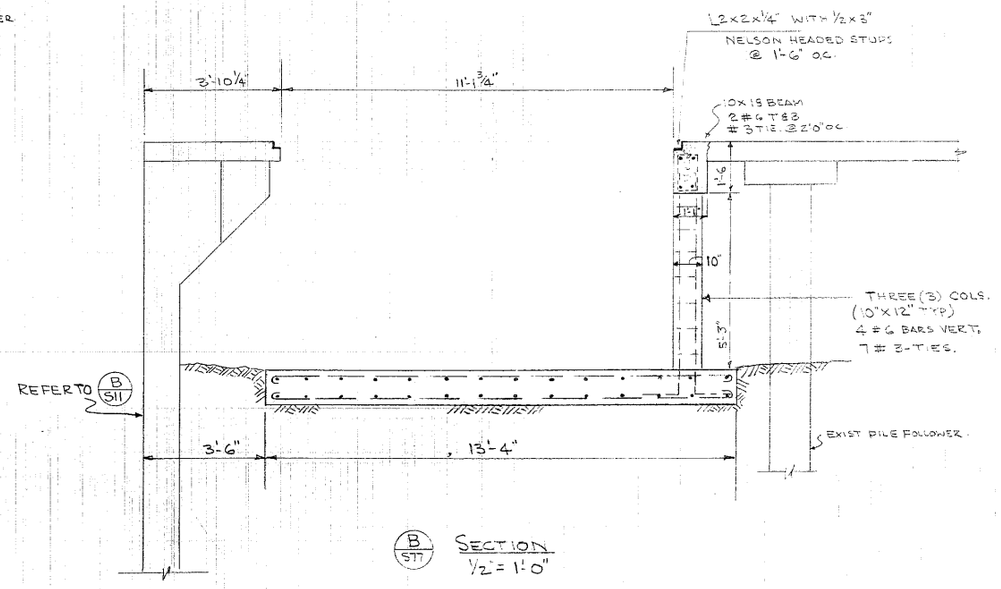

B S77 SECTION
½" = 1'-0"

NOTES

1. REFER TO DWGS S9, S10, S11 FOR HEAT TREAT ELEVATOR PIT
2. SEE DWG S78 FOR GRATING LAYOUT AND SALT POT SUPPORT FRAME

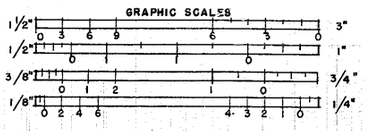

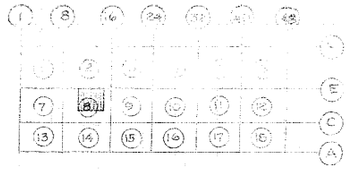

897196

24X -- DO NOT SCALE

SYM.	REVISION	BY	APPROVED	DATE
B	AS BUILT	EISI	JJ	2-14-68
A	ISSUED FOR CONSTRUCTION	EISI	EWC	12/26/67

ENGINEERED INDUSTRIAL SYSTEMS INC
CONSULTING ENGINEERS
SEATTLE WASHINGTON

DRAWN BY		DATE 12/26/67
CHECKED	JCJ	12/27/67
CHECKED		
APPROVED		
APPROVED		
APPROVED		

SUB TITLE: SALT POT PIT & SUPPORT SLAB
TITLE: M&I.S.D. RELOCATION (N.I.C.)
COLS 13-14 @ D' BLDG 12-02

SHEET S-77 OF
ISSUE B
JOB NO. 2967
DWG. NO. 1D7003-1197-077

FORMER NO. 1D7003-1145-077

WA0954RC