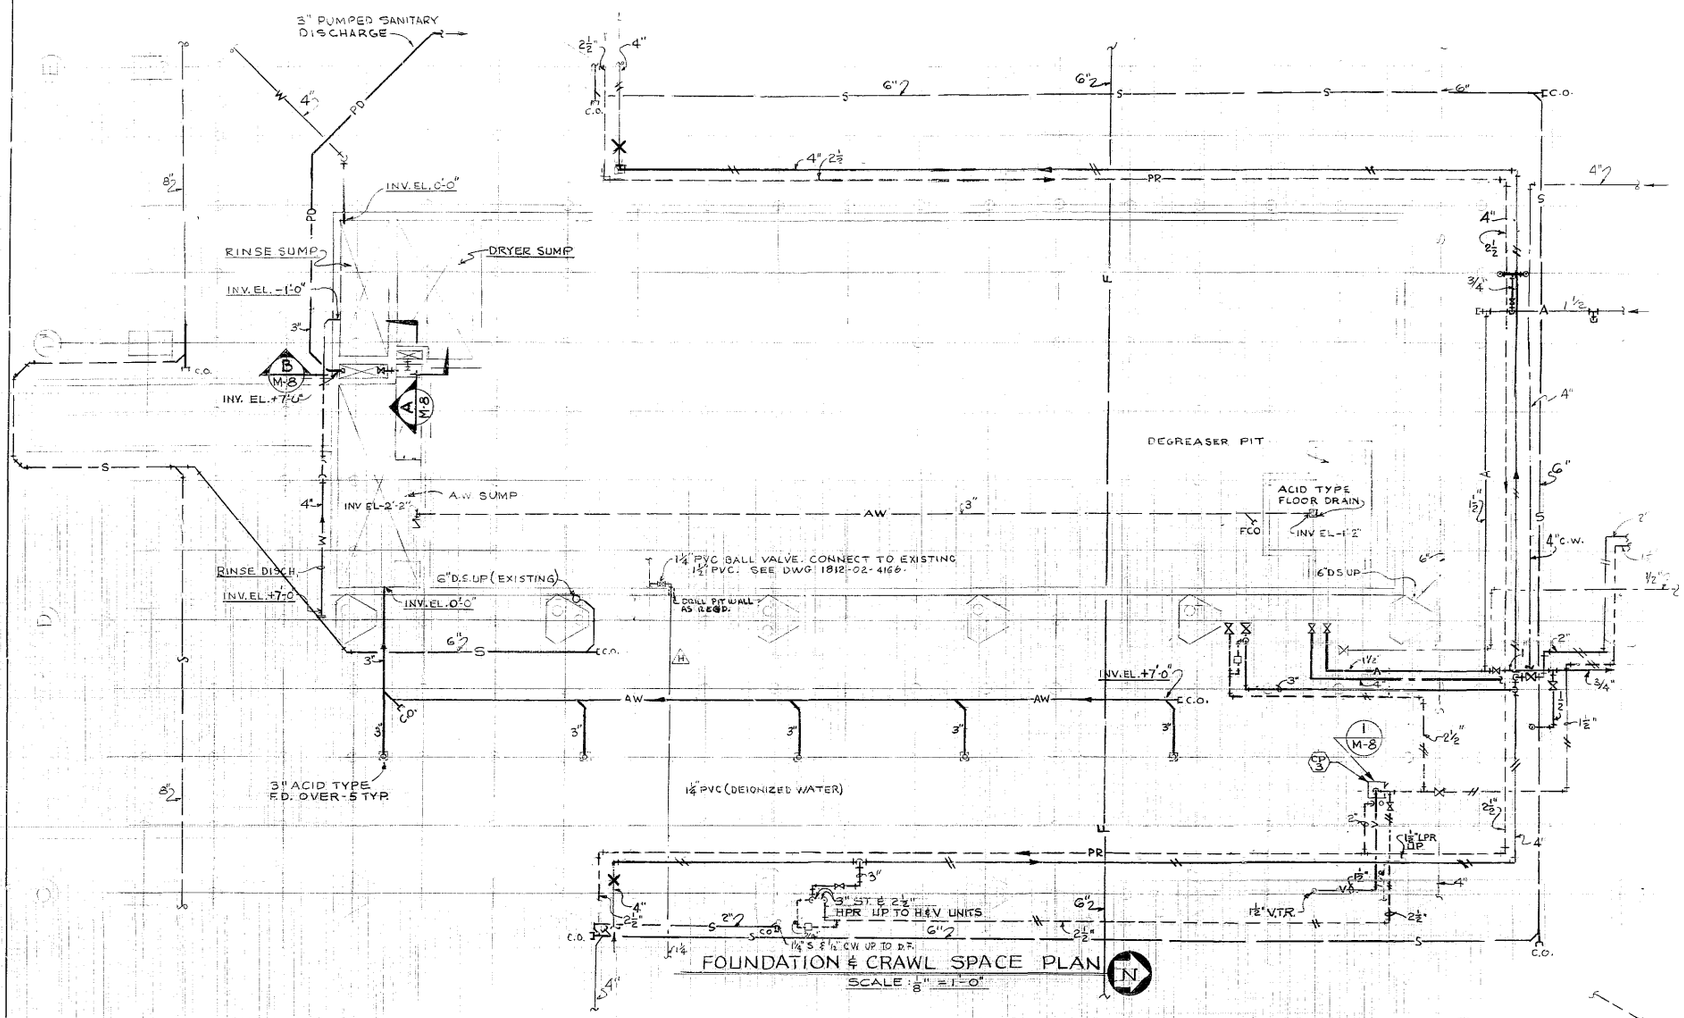

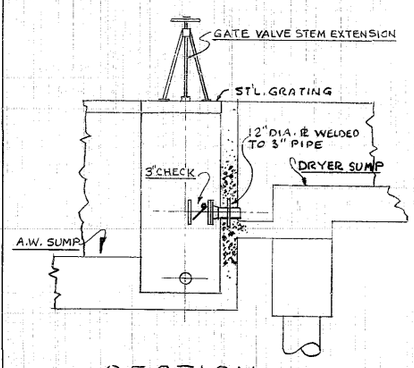

SECTION (A / M-8)
SCALE: ½" = 1'-0"

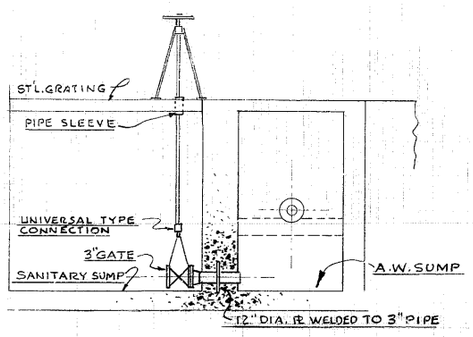

SECTION (B / M-8)
SCALE: ½" = 1'-0"

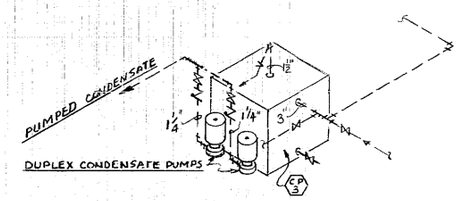

DIAGRAM (1 / M-8)
NOT TO SCALE

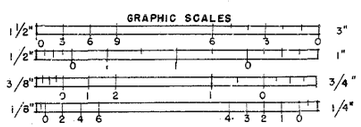

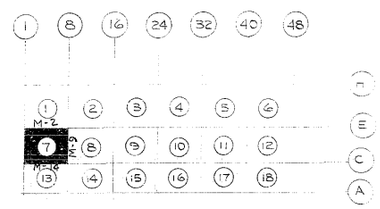

KEY PLAN BLDG. 12.02

897197

24X -- DO NOT SCALE

SYM.	REVISION	BY	APPROVED	DATE
H	ADD 1¼" PVC LINE	EISI	NRA	5-6-69
G	AS BUILT	EISI	RWP	3/15/68
F	EXTEND EXIST STEAM & COND. TO DEBURR AREA	EISI	RWP	3/6/68

SYM.	REVISION	BY	APPROVED	DATE
E	REVISED DEGREASER PIT & ACID WASTE LOCATION	EISI	RWP	11/15/67
D	ADDED FLAGNOTE 12 (RELOCATE COND. PUMP)	EISI	RWP	9/26/67
C	ISSUED FOR PHASE II	EISI	G.H.T.	9/25/67
B	ISSUED FOR CONSTRUCTION	EISI	G.H.T.	7/1/67
A	ISSUED FOR BID-CONTRACT ASD (FAC) 67-28	EISI	G.H.T.	6/12/67

ENGINEERED INDUSTRIAL SYSTEMS INC
CONSULTING ENGINEERS
SEATTLE WASHINGTON

DRAWN BY	E.I.S.I	DATE 5-31-67
CHECKED	G.H.T.	6/9/67
CHECKED		
APPROVED		
APPROVED		
APPROVED		

SUB TITLE: FOUNDATION PLAN
TITLE: MECHANICAL MASTER
COL. C-E, 1-8 BLDG. 12.02

SHEET M-8 OF
JOB NO. 295
DWG. NO. 1812-02-4157
ISSUE

WA0954RC