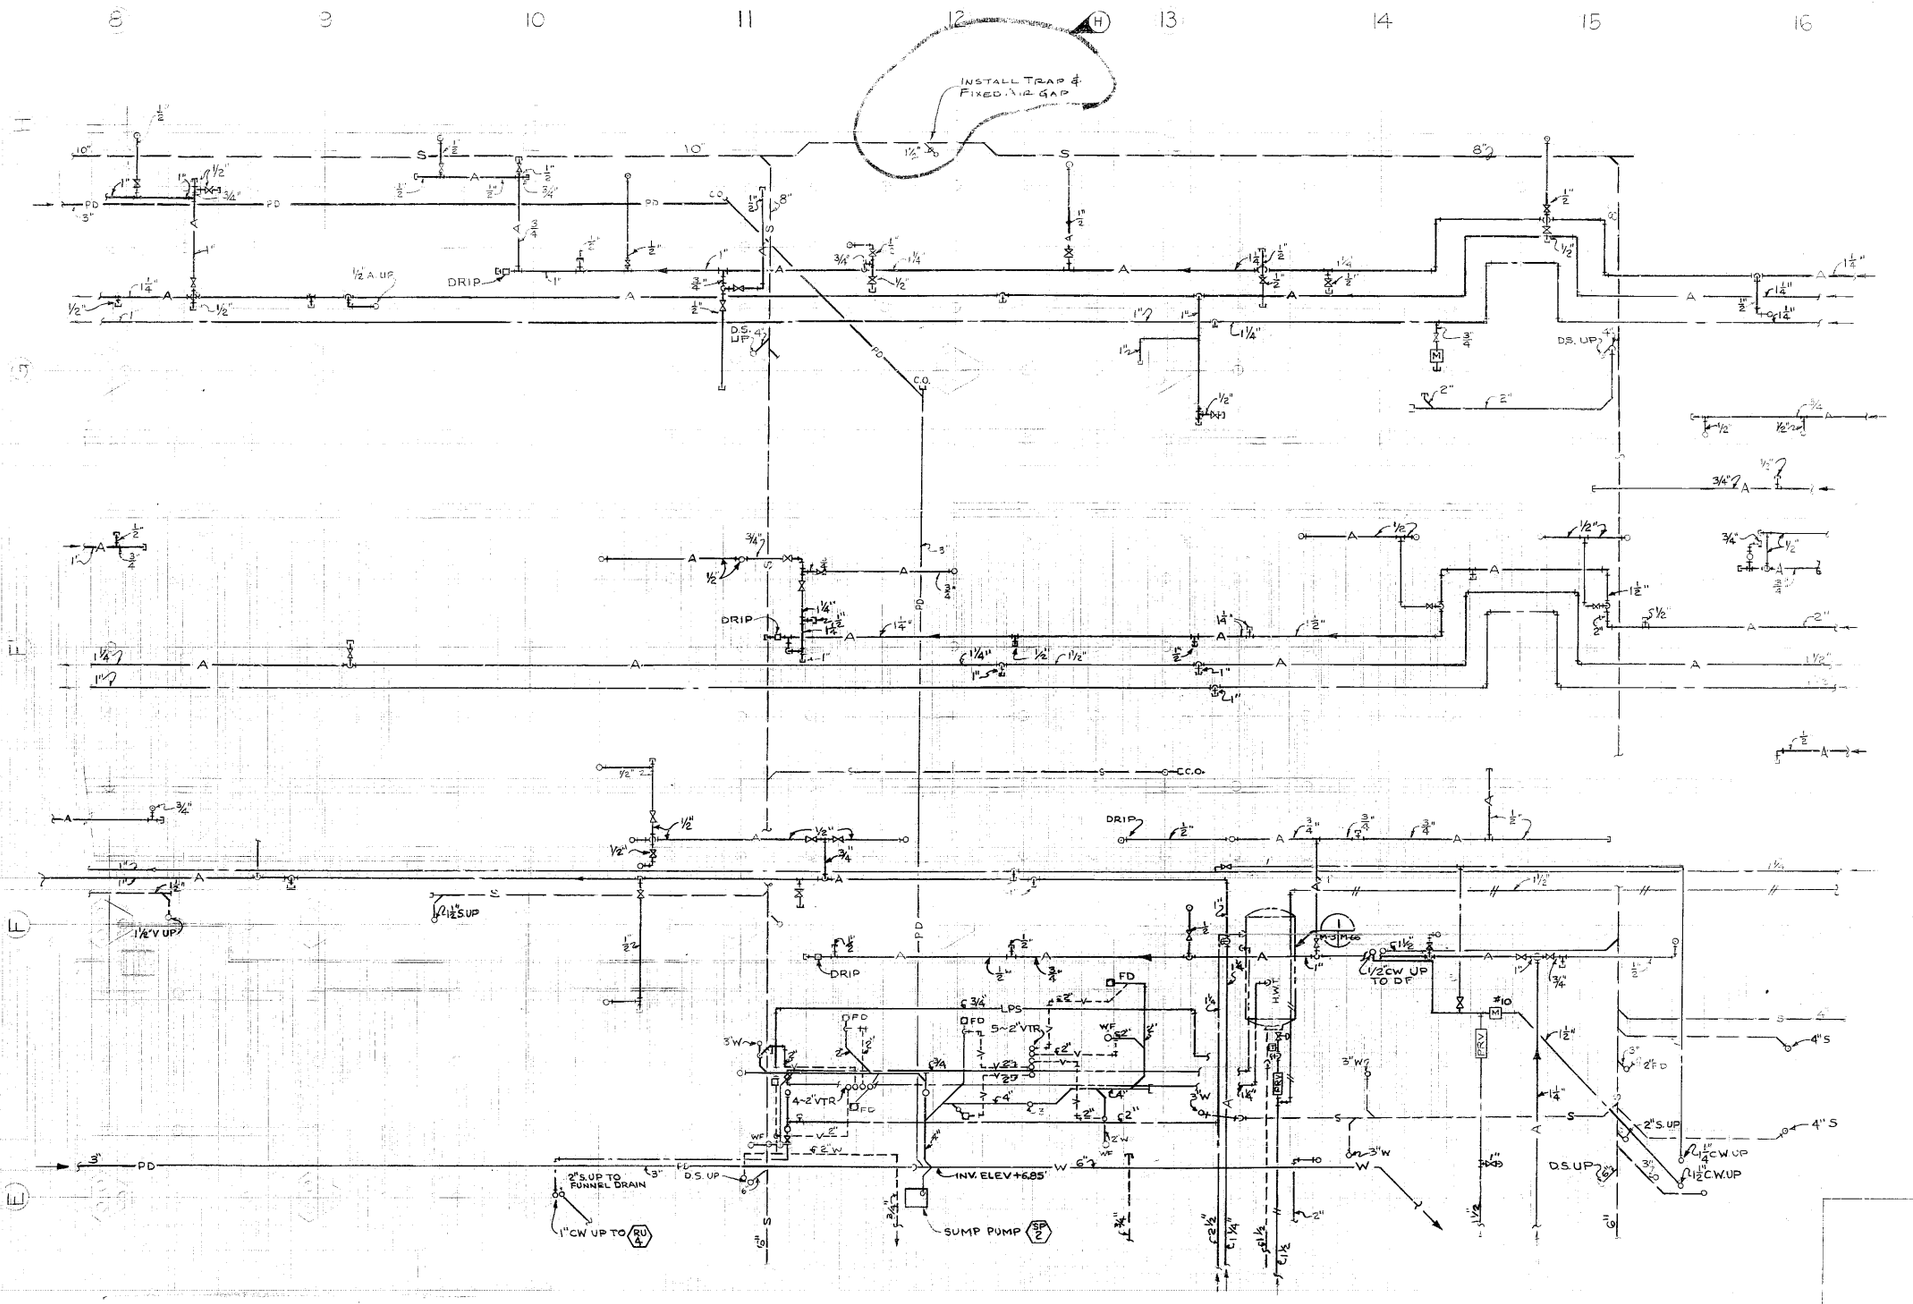

FOUNDATION & CRAWL SPACE PLAN

SCALE 1/8"=1'-0"

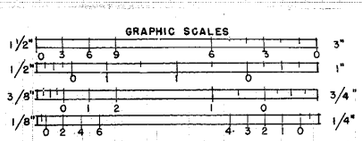

897199

24X -- DO NOT SCALE

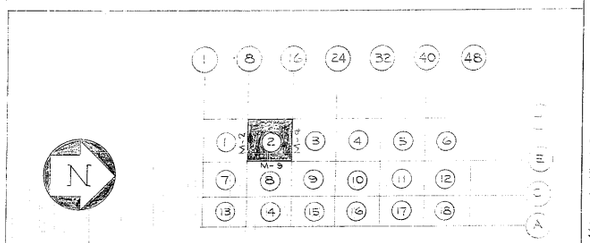

KEY PLAN BLDG. 12.02

SYM.	REVISION	BY	APPROVED	DATE
H	INSTALL DRAIN 793238	Wage		5/22/69
G	AS BUILT	EISI	RWP	3/15/68
F	REVISED PIPING	EISI	RWP	11/30/67
E	REVISED PIPING	EISI	RWP	11/15/67
D	ISSUED FOR PHASE II	EISI	G.H.T.	7/25/67
C	ISSUED FOR CONSTRUCTION	EISI	GHT	9/1/67
B	REVISION - ADDENDUM #1	EISI	GHT	6/26/67
A	ISSUED FOR BID - CONTRACT ASD (FAC) 67-28	EISI	GHT	6/12/67

ENGINEERED INDUSTRIAL SYSTEMS INC

CONSULTING ENGINEERS

SEATTLE WASHINGTON

		DATE
DRAWN BY	EISI	6/1/67
CHECKED	G.H.T.	6/9/67
CHECKED		
APPROVED		
APPROVED		
APPROVED		

SUB TITLE: FOUNDATION PLAN

TITLE: MECHANICAL MASTER

COL. E-H, 8-16 BLDG. 12.02

SHEET M-3 OF

ISSUE

JOB NO. 2967

DWG. NO. 12-002-4-57

WA0954KC