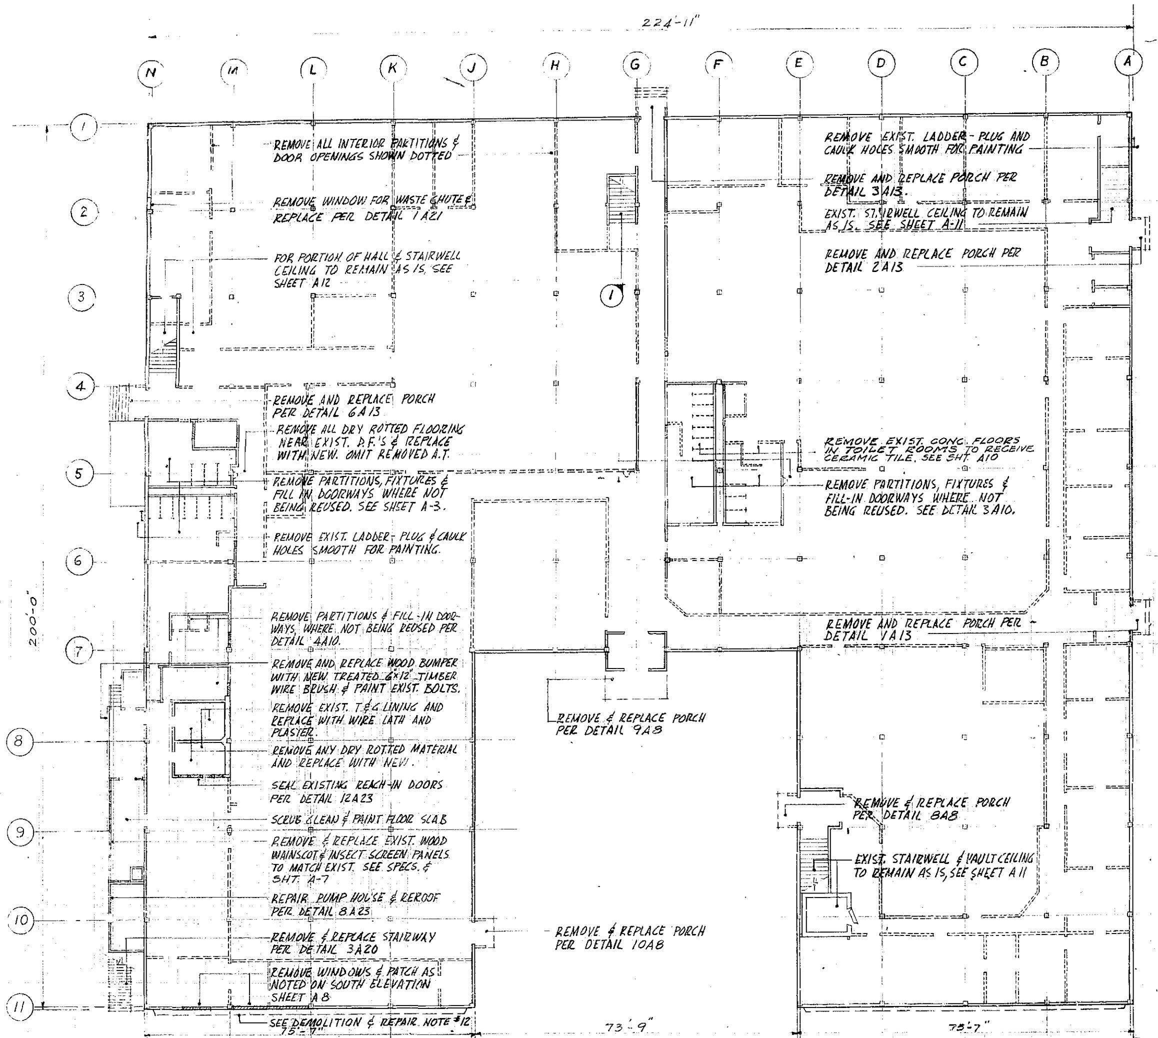

FIRST FLOOR DEMOLITION PLAN
1/16" = 1'-0"

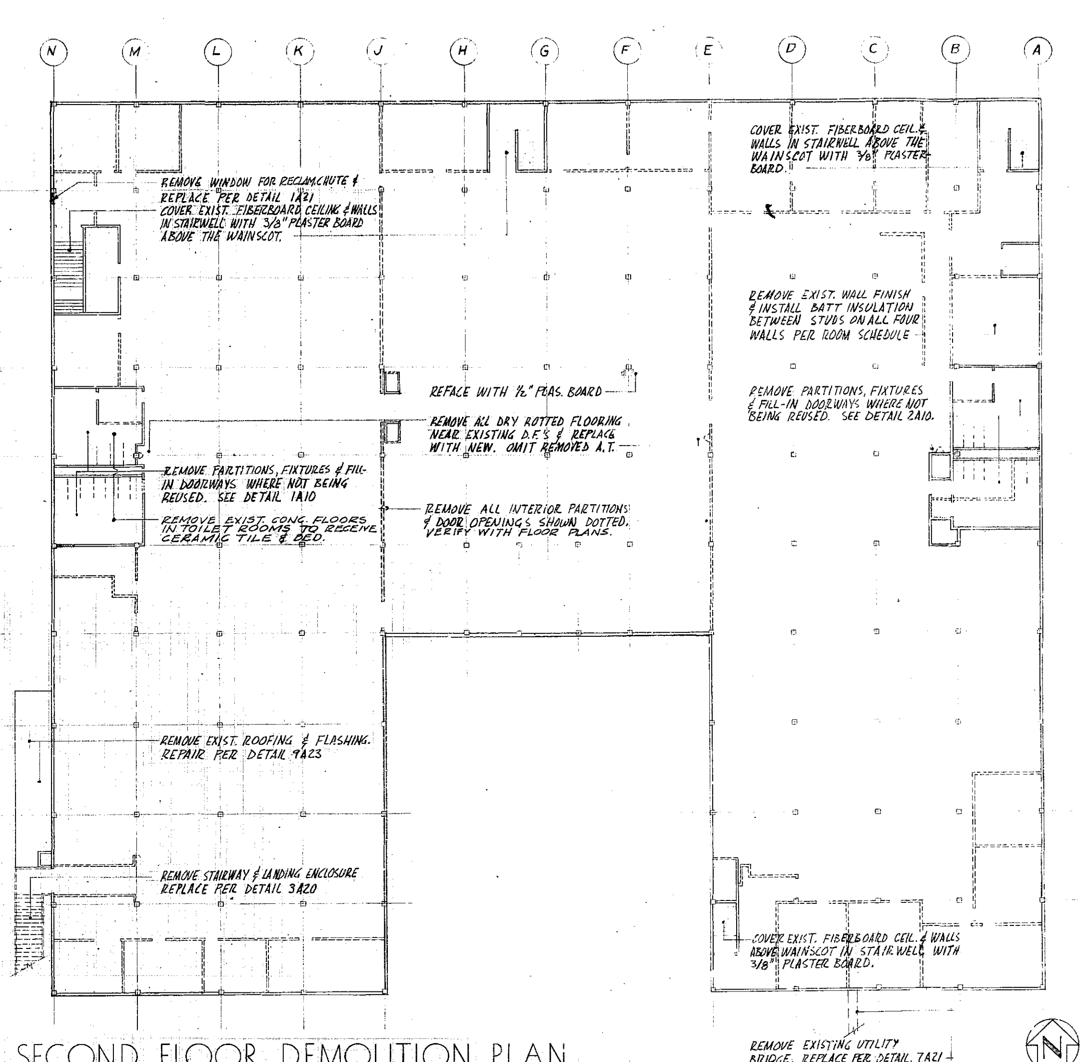

SECOND FLOOR DEMOLITION PLAN
1/16" = 1'-0"

DEMOLITION & REPAIR NOTES

1. REMOVE ALL EXISTING INTERIOR PARTITIONS AS INDICATED BY DOTTED LINES ON DEMOLITION PLAN AND NOT BEING REUSED. THIS INCLUDES ALL CONNECTIONS FROM THE FLOOR TO CEILING, AND ANY ATTACHED PIPING, WIRING OR FIXTURES. VERIFY WITH PLAN SHEETS.
2. REMOVE SUSPENDED CEILING OVER FIRST FLOOR AREA EXCEPT WHERE NOTED ON SHEETS A-11 & A-12
3. CUT INTO SECOND FLOOR CEILING ONLY AS NECESSARY TO INSTALL LIGHTING. REPLACE OR RENAIL TO CORRECT ANY DAMAGED OR SAGGING SECTIONS.
4. REMOVE EXISTING EXHAUST SYSTEMS NOT TO BE REUSED ON THIS JOB. VERIFY WITH MECHANICAL PLANS.
5. REMOVE EXISTING KITCHEN RANGE HOOD, SUPPORTS, AND DUCTS. NOT TO BE REUSED. SEE MECHANICAL PLANS.
6. REMOVE AND FILL-IN EXISTING LOUVERS PER NOTES AS SHOWN ON EAST AND WEST ELEVATIONS, SHEET A7.
7. WHERE LOUVERS, VENTS, DUCTS, PIPES, ETC. THROUGH WALLS ARE REMOVED REPLACE SASH AND/OR FILL-IN WALLS AS REQUIRED TO MATCH NEW FINISH MATERIAL.
8. REMOVE AND REPLACE EXISTING FOUNDATION LOUVER PANELS WITH 1/4" HARDWARE CLOTH IN RAT PROOF METAL FRAME PER DETAIL 6A8
9. REMOVE AND REPLACE ALL UNDERFLOOR VENTS AND SCREENS WITH 1/4" HARDWARE CLOTH IN METAL FRAME PER DETAIL.
10. MAKE ENTIRE FOUNDATION AREA RAT PROOF AT ALL THRU-WALL PIPES, ACCESS PANELS, VENT OPENINGS, ETC.
11. SECURE WINDOW VENTS IN CAFETERIA AIR TIGHT.
12. REMOVE THE PROTECTIVE RAILING AT WINDOWS ON SOUTH WALL OF EAST AND WEST WINGS ABOVE WALK. PATCH SIDING COMPLETELY WATERTIGHT AND SMOOTH FOR PAINTING.
13. REMOVE ANY AND ALL DRY ROTTED SIDING, WINDOWS, ETC. & REPAINT.
14. NAIL DOWN ALL LOOSE OR CURLED SIDING, TRIM, ETC. CAULK JOINTS.
15. REMOVE AND REPLACE ALL DRY ROTTED FLOORING BEFORE APPLYING NEW FLOORING ADJACENT TO DRINKING FOUNTAINS AND ANY OTHER AREAS.
16. SECURE ANY LOOSE ASPHALT TILE AND FILL ALL VOIDS, CRACKS, AND DEPRESSIONS WITH LATEX UNDERLAYMENT AS SPECIFIED.
17. RESET FLOOR DRAINS IN KITCHEN AND TOILET ROOMS TO PROPER LEVEL FOR DRAINAGE WITH NEW FLOORING. SEE MECH. PLAN.
18. DRILL HOLES AND INSTALL MIDGET LOUVERS FOR STUD SPACE VENTILATION OF ALL EXTERIOR WALLS AS SPECIFIED.
19. REMOVE ALL PROTRUDING UNUSED ANCHOR BOLTS, BRACKETS, OR OTHER ITEMS ON EXPOSED WALLS AND PATCH ALL HOLES SMOOTH FOR PAINTING PER ROOM SCHEDULE.
20. REPLACE INSECT SCREENING AT WINDOWS [illegible] 105 177, 178 & 180 WITH NEW COPPER SCREEN.
21. REMOVE EXISTING WOOD PORCH ROOFS, WING WALLS, WOOD STAIRS, PORCHES & SUPPORTS AS NOTED & REPLACE PER DETAILS SHTS. A8 & A13.
22. REMOVE EXIST. EXTERIOR WALL INTERIOR FINISH MATERIALS AND REPLACE WITH NEW AS DETAILED & NOTED.
23. RAISE ROOF PENTHOUSE DOOR SILLS TO LINE WITH NEW FLASHING PER DET. 17A20.

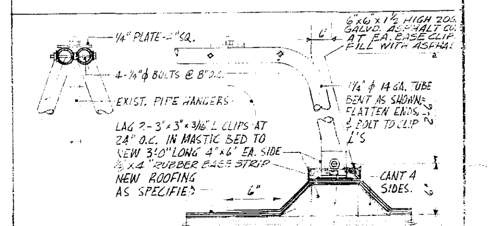

13A1
1½" = 1'-0"

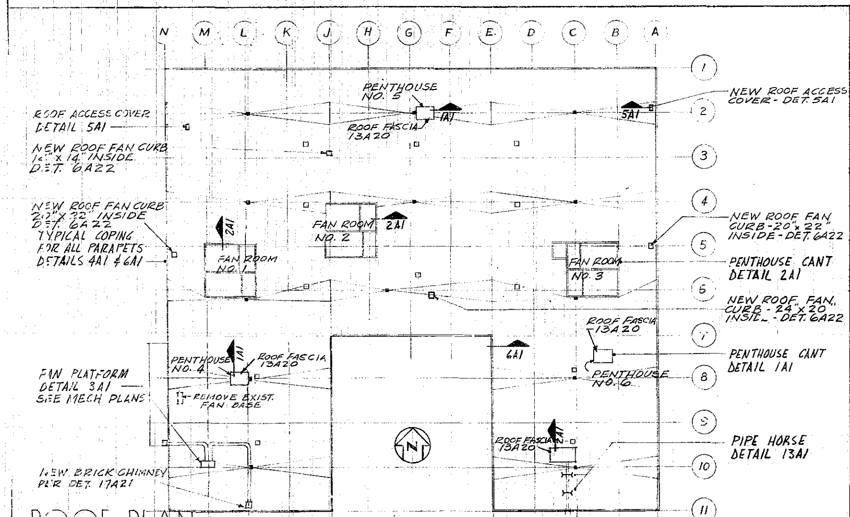

ROOF PLAN
1/32" = 1'-0"

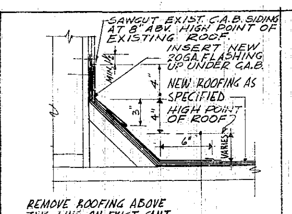

2A1 FLASHING AT FAN ROOMS
1½" = 1'-0"

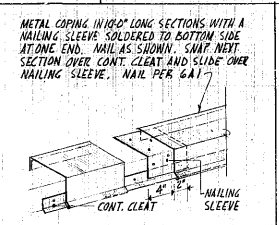

4A1
NO SCALE

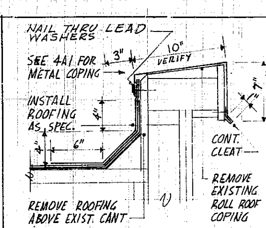

6A1
1½" = 1'-0"

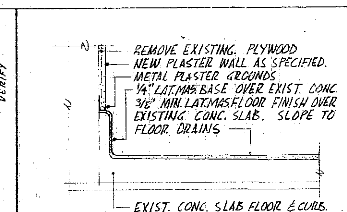

8A1
1½" = 1'-0"

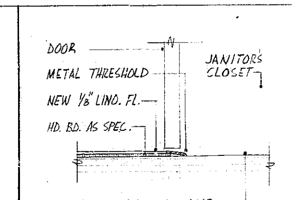

10A1
1½" = 1'-0"

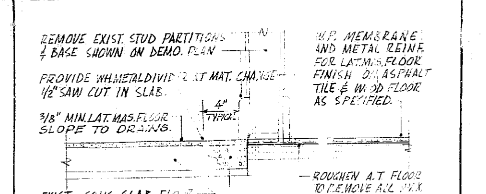

12A1
1½" = 1'-0"

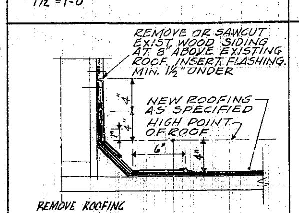

1A1 FLASHING AT PENTHOUSES
1½" = 1'-0"

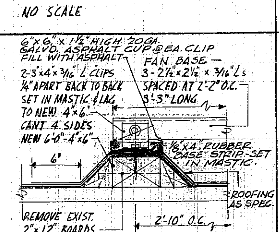

3A1
1½" = 1'-0"

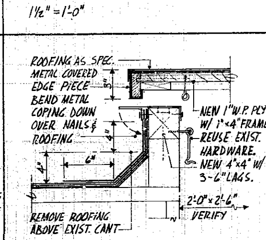

5A1
1½" = 1'-0"

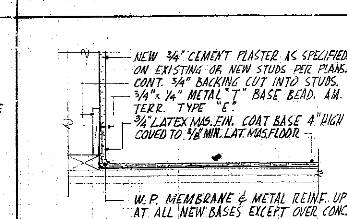

7A1
1½" = 1'-0"

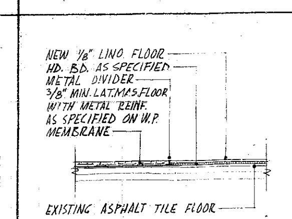

9A1
1½" = 1'-0"

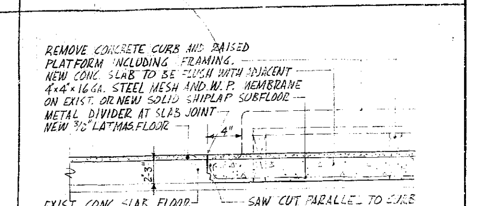

11A1 EXIST. KITCHEN CURB REMOVAL DETAIL
1½" = 1'-0"

DATE	NO	REVISION
7-?-59	1	ADDITIONAL DEMOLITION OF PARTITION
9-11-59	2	AS BUILT

GRAPHIC SCALES

HARMON PRAY & DETRICH
ARCHITECTS • ENGINEERS
SEATTLE WASHINGTON
JOB NO 71239-1
DATE 10-27-58

HARMON, PRAY & DETRICH — RENEWED TO JUNE 1 1959 — TL-343 — STATE OF WASHINGTON — REGISTERED ARCHITECTS - ENGINEERS

BOEING MISSILE PRODUCTION CENTER
PHASE III BUILDING 12-20
BOEING AIRPLANE COMPANY SEATTLE WASH.
DEMOLITION PLAN 112-020-1000-A1
71239-1
A1
SHEET NO.
722
WA0960KC

24X -- DO NOT SCALE
897274