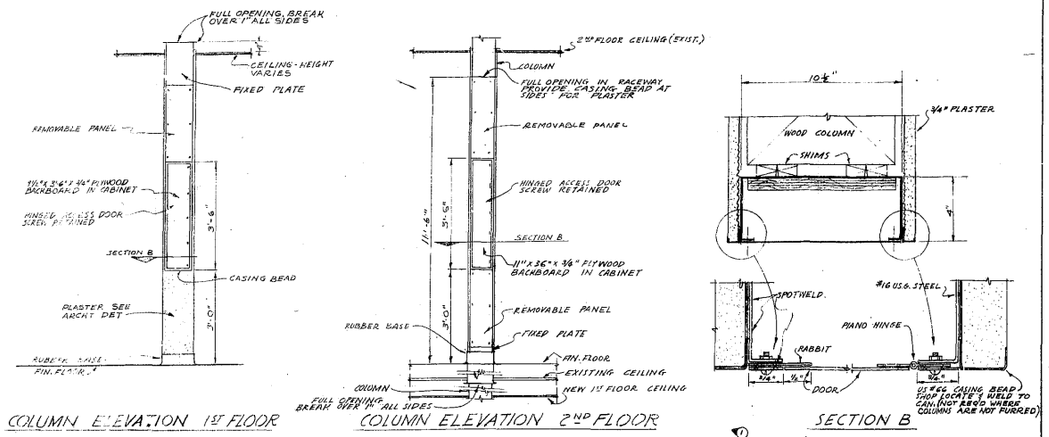

COLUMN ELEVATION 1ST FLOOR

COLUMN ELEVATION 2ND FLOOR

SECTION B

① TELEPHONE CABINET & WIREWAY DETAILS

(REFER TO SHEET A20, DETAIL #19 A20)
NO SCALE

4E-10

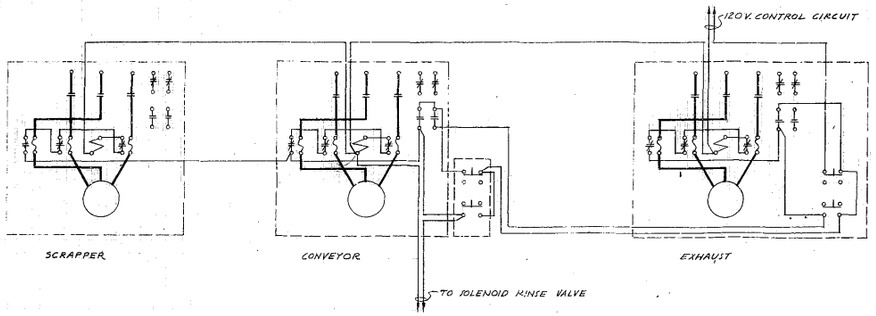

DISHWASHER CONTROL DIAGRAM

NO SCALE

5E-10

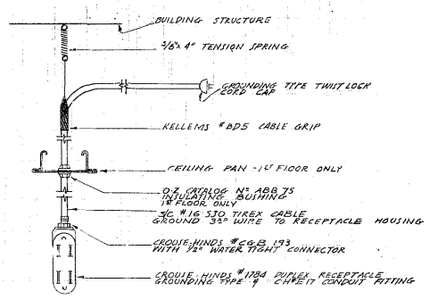

① RECEPTACLE DROP DETAIL

NO SCALE

6E-10

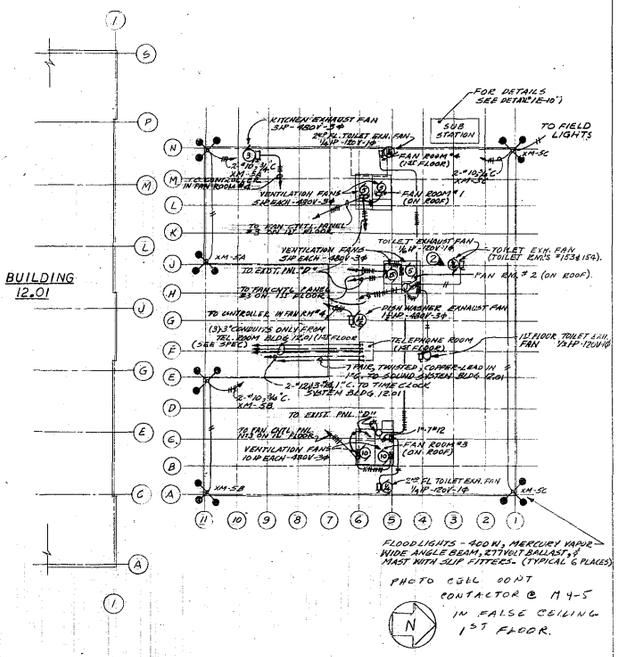

ROOF PLAN ②

1" = 40'-0"

3E-10

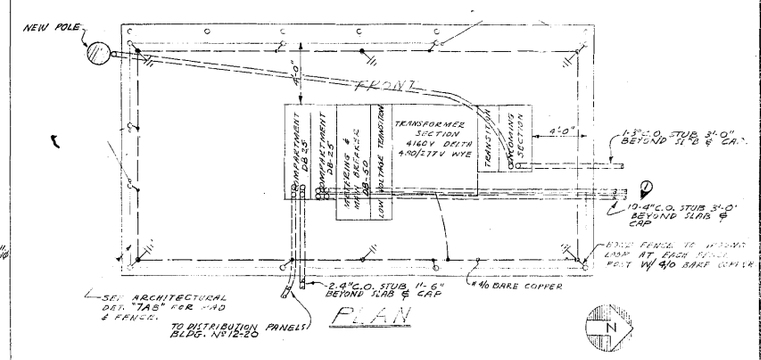

NOTE: ALL CONDUIT TO HAVE 24" MIN. COVER.

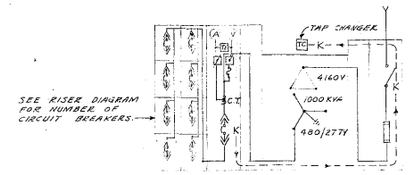

SUBSTATION DETAILS

ARRANGEMENT

1E-10

NO SCALE

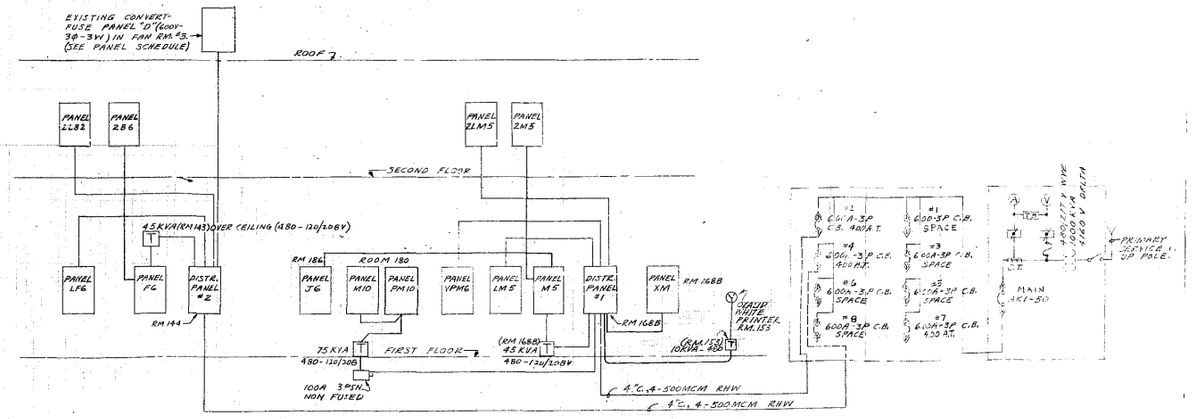

RISER DIAGRAM

2E-10

NO SCALE

897275

24X -- DO NOT SCALE

DATE	NO	REVISION
2/8/58	①	REVISED IN CONFORMANCE WITH THE CHANGE TO A REJECT DROP SYSTEM PER CHANGE ORDER No. 1
1-7-59	②	DELETE OZALID FAN & ADD TOILET FAN
7-14-59	③	AS-BUILT

DATE	NO	REVISION

DATE	NO	REVISION

HARMON PRAY & DETRICH
ARCHITECTS • ENGINEERS
SEATTLE • WASHINGTON

JOB NO 71239-1

DATE 10-27-58

BOEING MISSILE PRODUCTION CENTER
PHASE III BUILDING 12-20
BOEING AIRPLANE COMPANY SEATTLE WASH.

ELECTRICAL DETAILS

71239-1
E10
SHEET NO.

WA096KG

112-020-2001-E130