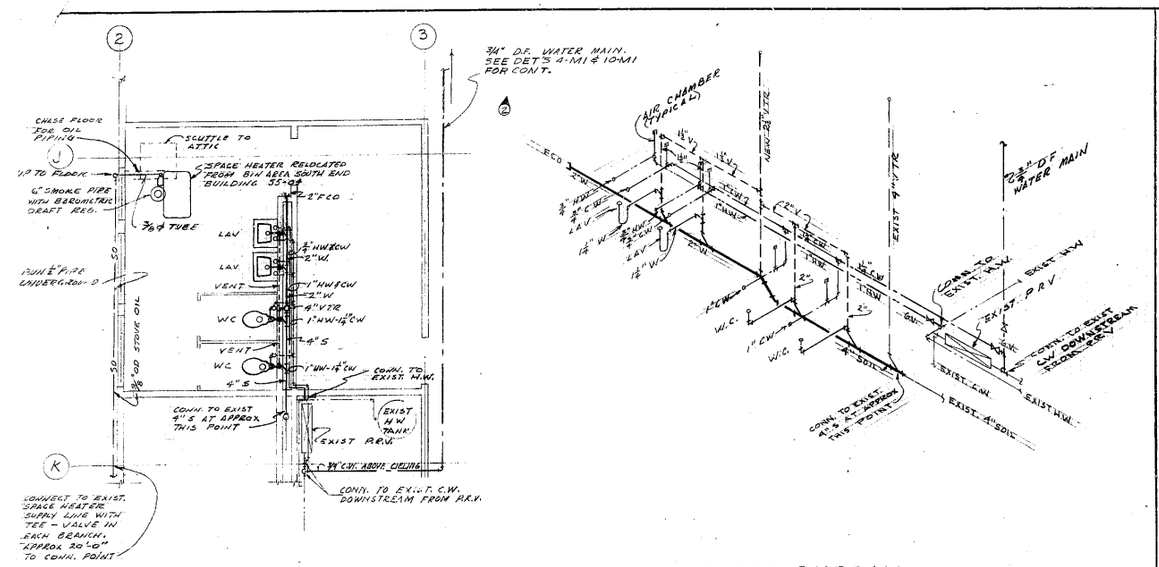

PLAN
TOILET ROOM DETAILS - BUILDING 55-03
1/4" = 1'-0"

PLUMBING RISER DIAGRAM

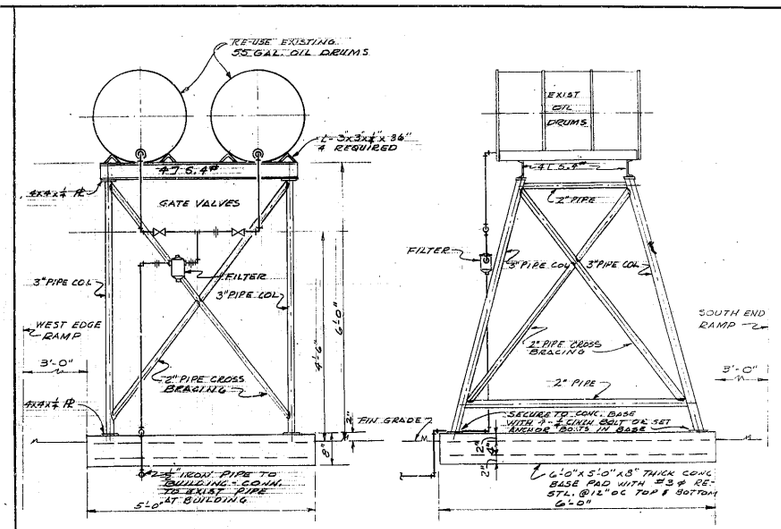

FUEL OIL DRUM STAND - BLDG. 55-04
1-M1
3/4" = 1'-0"

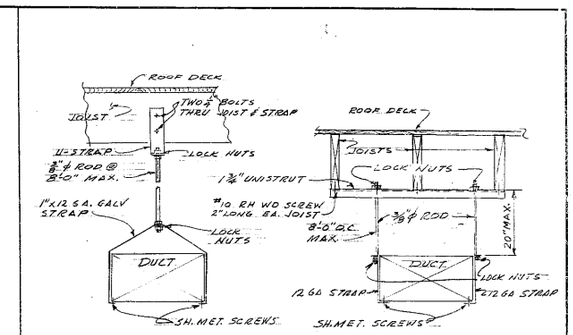

DUCT HANGERS - SIZE 35" AND SMALLER
2-M1
NOT TO SCALE

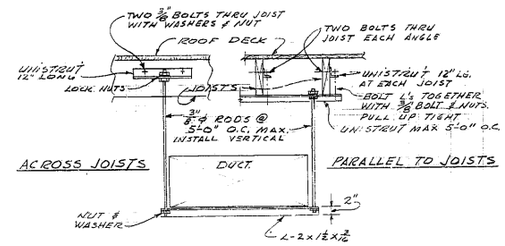

DUCT HANGER SIZE 35" & LARGER
7-M1
NOT TO SCALE

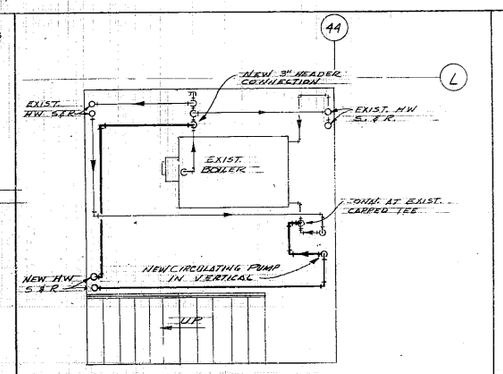

BOILER ROOM PLAN
5-M1
1/4" = 1'-0"

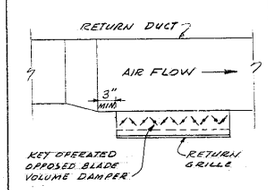

RETURN GRILLE
6 M1
NOT TO SCALE

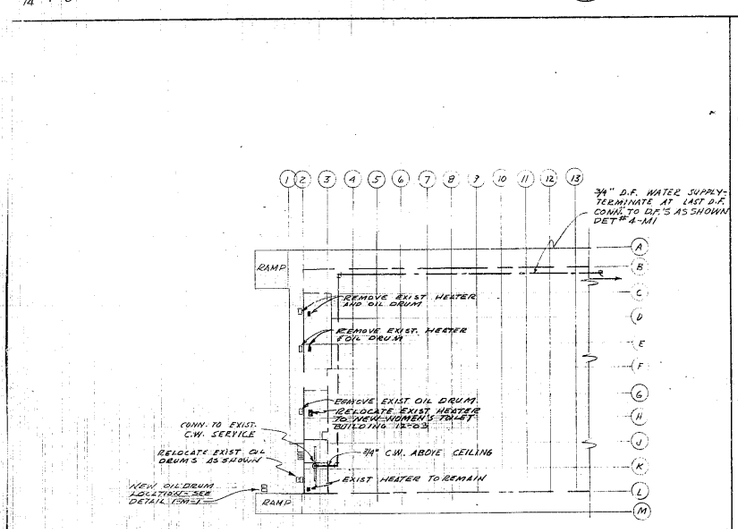

PARTIAL PLAN BUILDING 55-04
1" = 50'

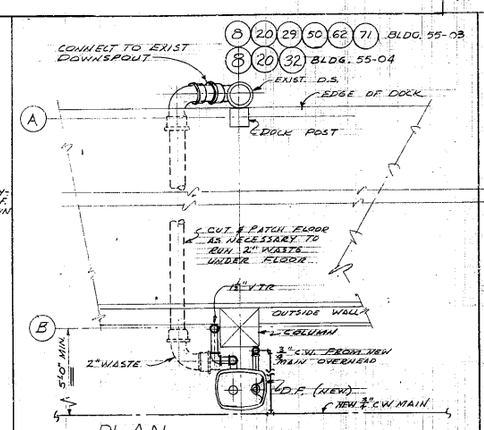

PLAN

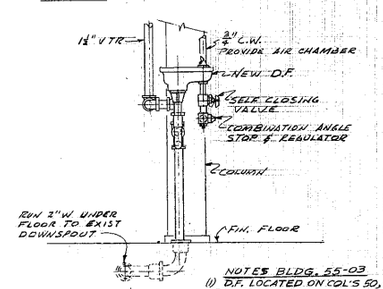

ELEVATION

NOTES BLDG. 55-03
(1) D.F. LOCATED ON COL'S 50, 62 & 71 TO BE SUPPLIED FROM TOILET RM. #15
(2) D.F. LOCATED ON COL'S 8, 20 & 29 TO BE SUPPLIED FROM TOILET RM. #2

DRINKING FOUNTAIN DETAILS
4-M1
1" = 1'-0"

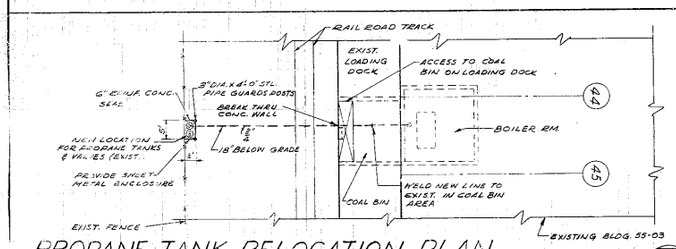

PROPANE TANK RELOCATION PLAN
10-M1
1/16" = 1'-0"

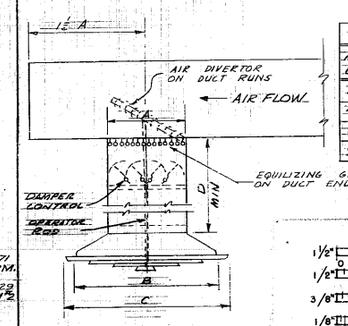

DIFFUSER SCHEDULE

MAX. CFM	SIZE	NECK OPENING A	CEILING OPENING B	OVERALL DIAMETER C	NECK HEIGHT D
200	6	6"	11"	12 5/8"	10 3/4"
400	8	8"	14 3/4"	16 15/16"	10 3/4"
600	10	10"	NOT APPL.	21 1/4"	12 1/2"
900	12	12"	NOT APPL.	25 3/8"	12 1/2"

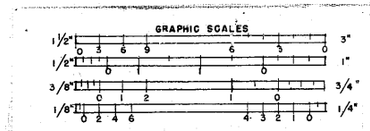

TYPICAL DIFFUSER
8-M1
NOT TO SCALE

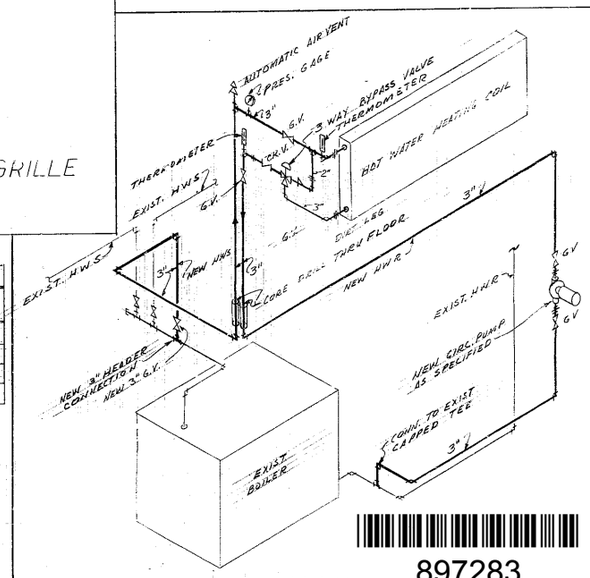

HEATING WATER PIPING DIAGRAM
9-M1
NOT TO SCALE

897283

24X -- DO NOT SCALE

155-003-4033-M1

DATE	NO	REVISION
6-27-58	1	ADDENDUM NO. 1 - ADD DET. 10-M1
8-20-58	2	REVISED NOTE AS SHOWN
11-6-58	3	AS BUILT

DATE	NO	REVISION

DATE	NO	REVISION

HARMON PRAY & DETRICH
ARCHITECTS · ENGINEERS
SEATTLE WASHINGTON
JOB NO 8011
DATE 6-19-58

MODIFICATIONS TO BLDGS 55-03 & 55-04
WHS'E. 55 SEATTLE ARMY TERMINAL
BOEING AIRPLANE COMPANY SEATTLE, WASH

8011
M-1
SHEET NO.

PLUMBING PLAN & MISCELLANEOUS DETAILS

B. A. C. APPROVAL 5/22/58 WA09758C

683