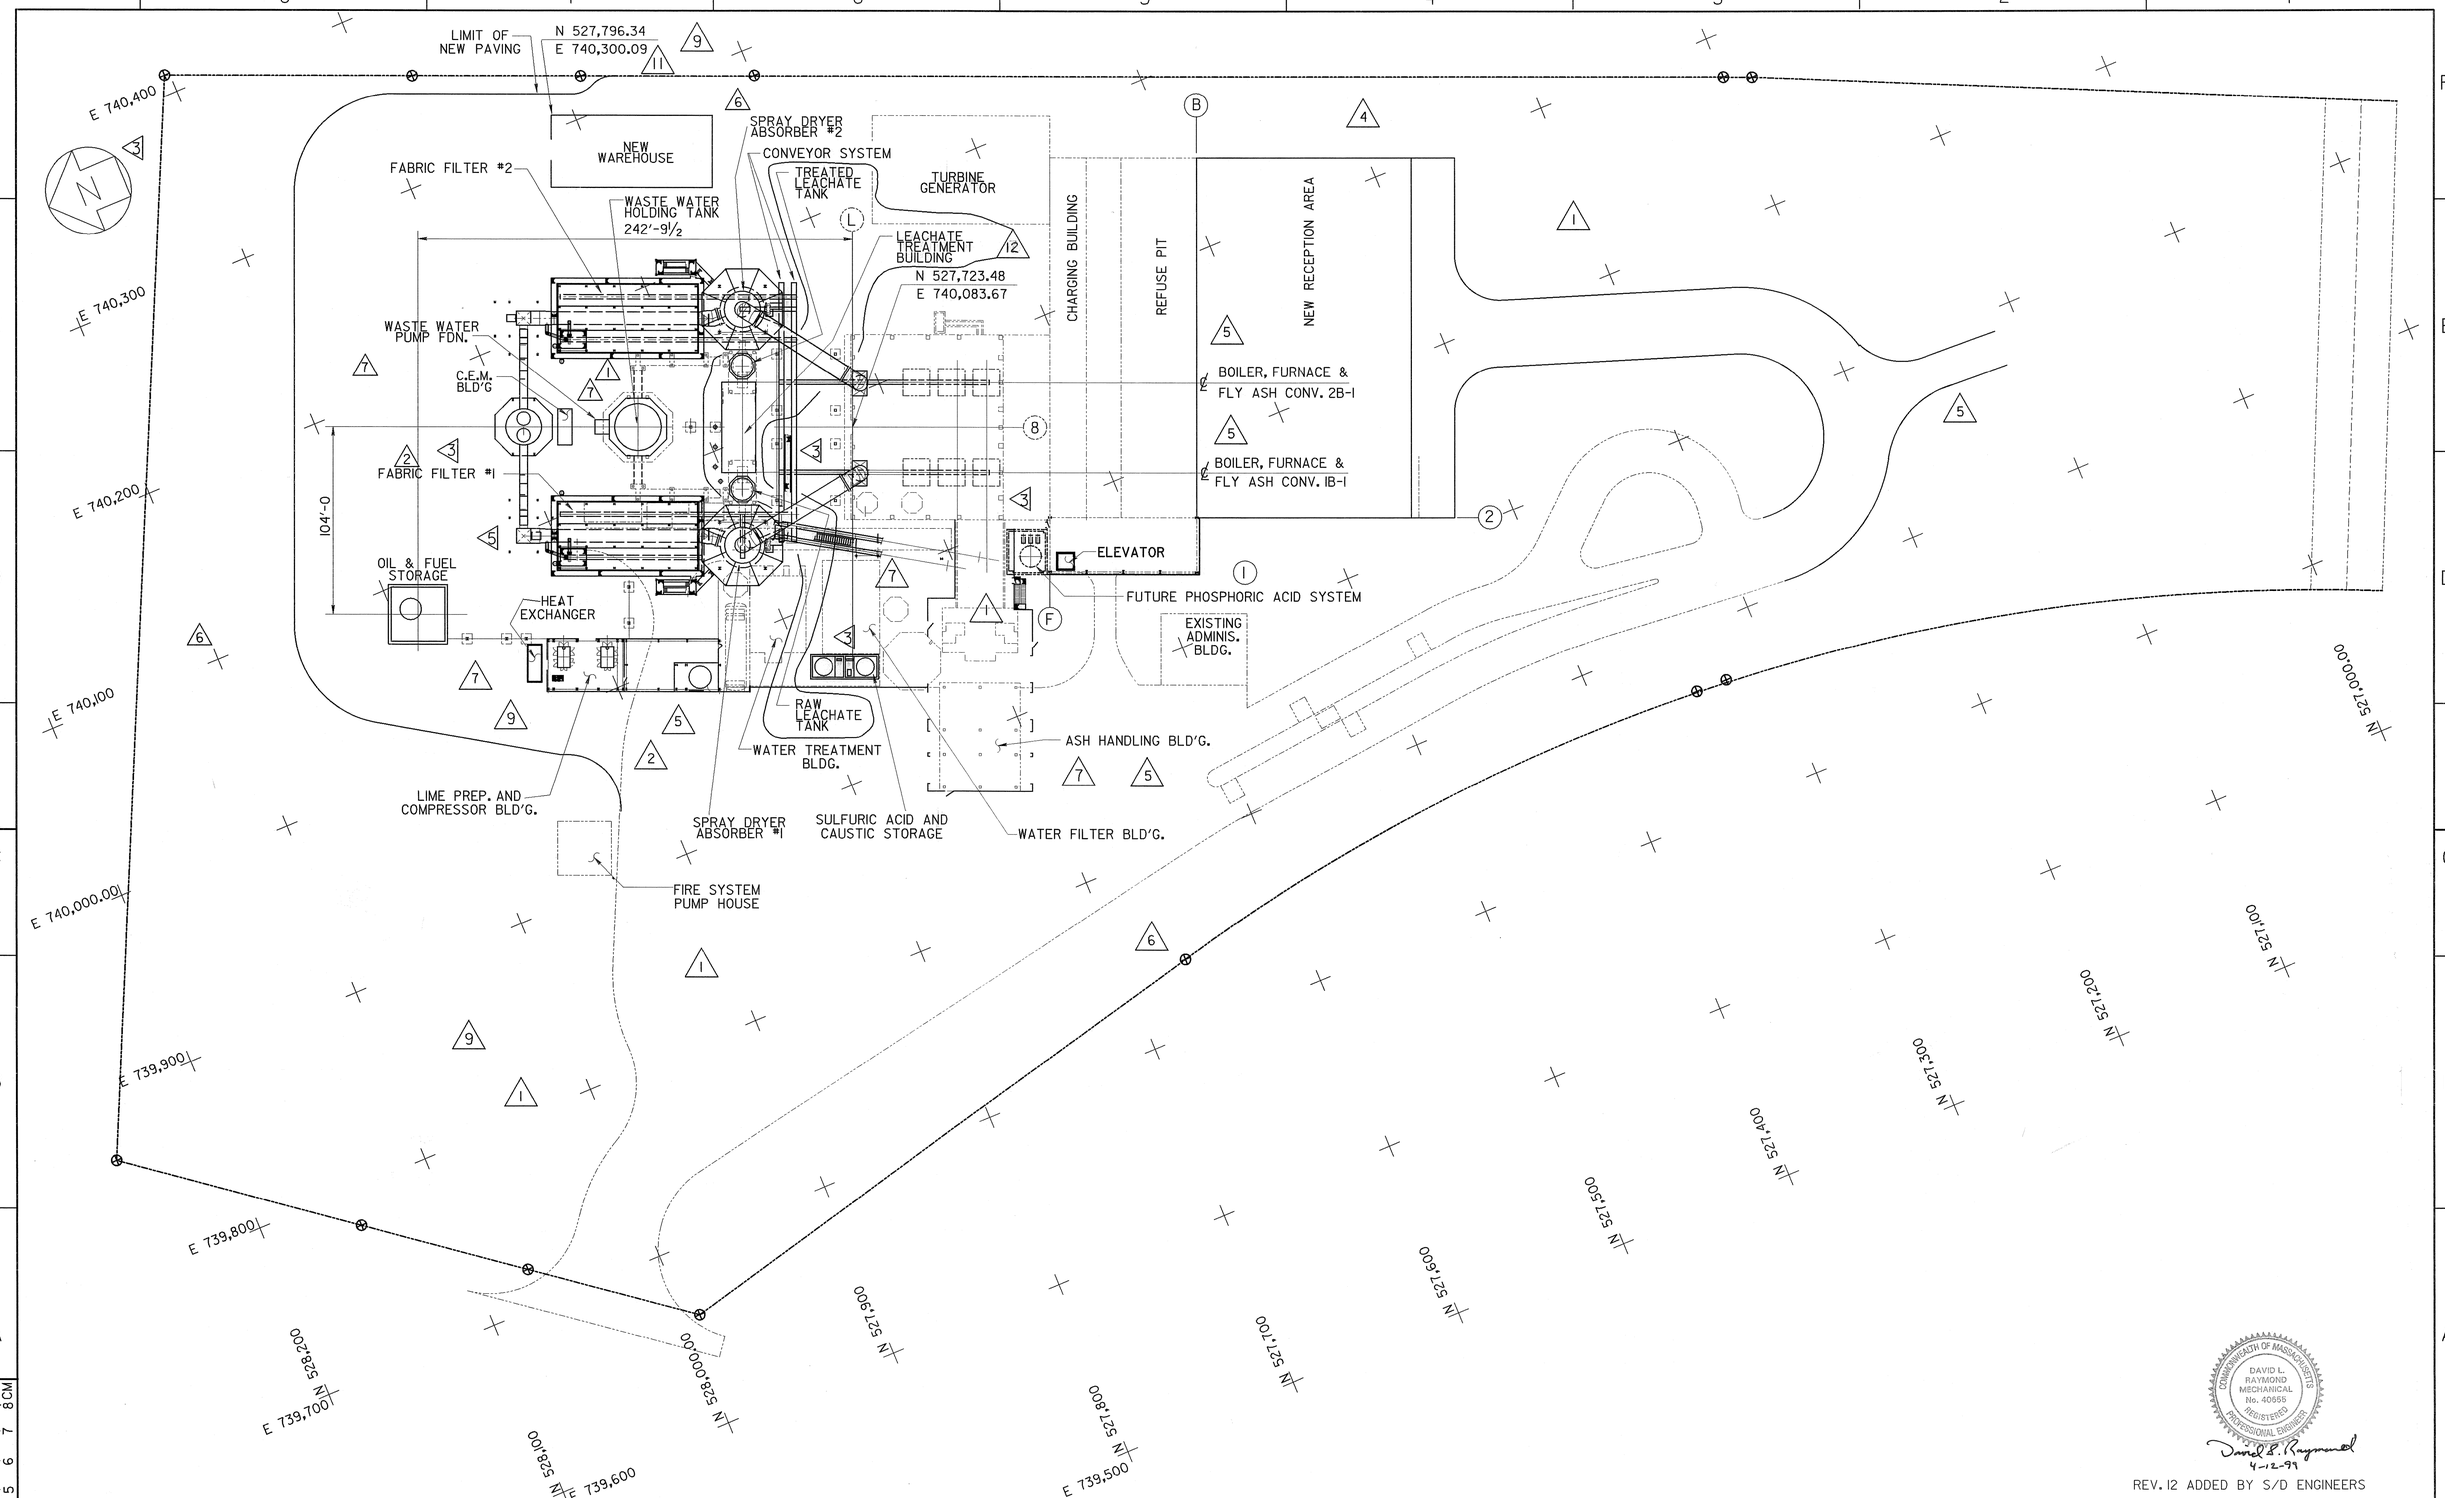


REV. 12 ADDED BY S/D ENGINEERS

| No. | REVISION | MADE | CKD. | DATE | No. | REVISION | MADE | CKD. | DATE | DRAWING No. | REFERENCES |
|---|---|---|---|---|---|---|---|---|---|---|---|
| 7 | GENERAL REVISION | S.K. | J.S. | 8-16-89 | 8 | GENERAL UPDATE FOR DESIGN RELEASE | WFC | J.S. | 10/12/89 | | |
| 6 | ADDED SETBACK DIM. | S.K. | E.J. | 7-20-89 | 9 | ADDED WAREHOUSE & GENERAL UPDATE | WFC | J.S. | 12/06/89 | | |
| 5 | GENERAL REVISION | S.K. | E.J. | 7-7-89 | 10 | GENERAL REVISION | RBK | J.S. | 3/30/90 | | |
| 4 | REVISED RECEPTION BLD'G & ADD HOLD | R.D. | E.J. | 12-15-88 | 11 | RELOCATED WAREHOUSE | WFC | J.S. | 5/04/90 | | |
| 3 | REVISED PER APP'L COMMENTS | R.D. | E.J. | 8-3-88 | 12 | ADDED LEACHATE TREATMENT AS BUILT | STL | | 4/09/99 | | |
| 2 | RELOCATE LIME PREP. BLD'G, ADD PUMP FDN. | R.D. | E.J. | 7-26-88 | | | | | | | |
| 1 | GENERAL REVISION | R.D. | N.B. | 7-11-88 | | | | | | | |

| | | DATE |
|---|---|---|
| SCALE | 1" = 40' | |
| DESIGN BY: | | |
| DRAWN BY: | R.D. | 6-15-88 |
| CHECKED BY: | E.J. | 7-26-88 |
| SUPV.BY: | E.J. | 7-26-88 |
| SUBM'TD BY: | G.B. | 7-26-88 |
| APP'D BY: | | |
| APP'D BY: | | |
| APP'D BY: | | |

SAUGUS / RESCO
SCRUBBER/FABRIC FILTER ADDITIONS
SAUGUS, MASSACHUSETTS

PLOT PLAN

Rust International Corporation
Pittsburgh, Pennsylvania
Contract 21-3347-A

DRAWING NUMBER 01-27-1000 REV. 12

LAST WORKED ON 05-04-90

QSA2:[30,152]01271000.DGN

ON ORIGINAL 0" 1" 2" 3" 0 1 2 3 4 5 6 7 8 CM

E:\saugus\01271000.dgn Apr. 09, 1999 10:31:15