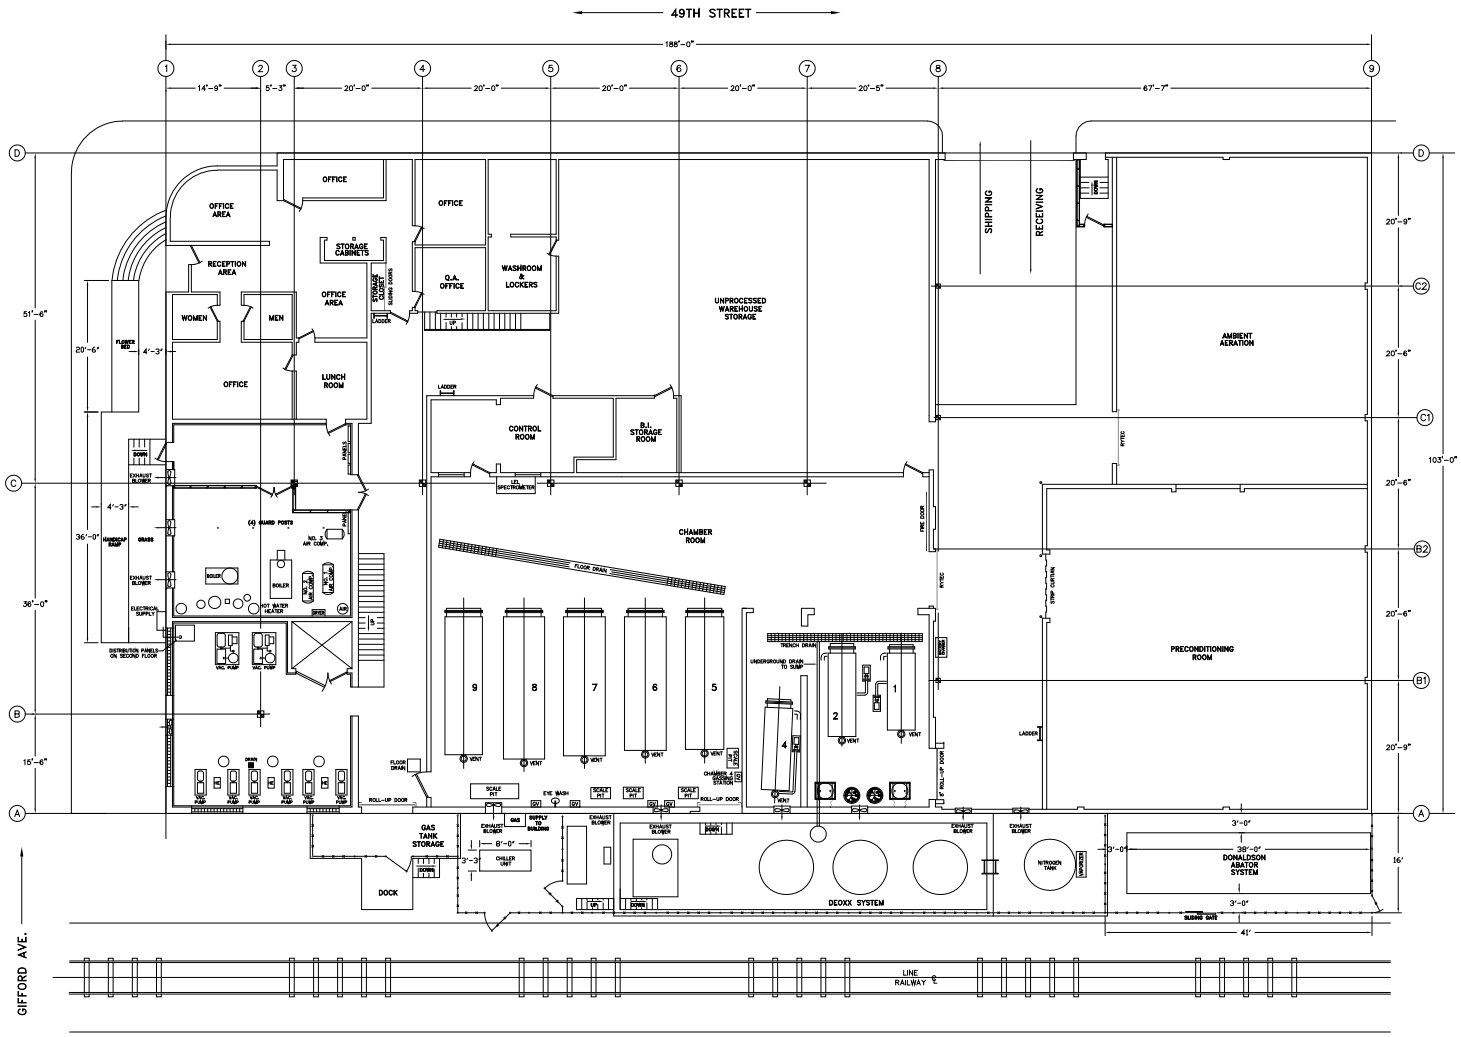


## LOS ANGELES, CALIFORNIA PLANT LAYOUT

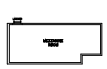

**SECOND FLOOR MEZZANINE ABOVE CONTROL ROOM**

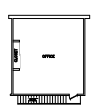

**SECOND FLOOR OFFICE ABOVE Q.A. OFFICE**

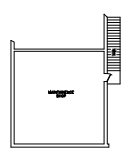

**SECOND FLOOR MAINTAINENCE ABOVE PUMP ROOM**

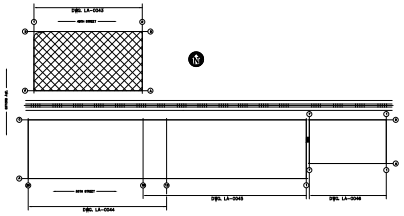

FINAL AS-INSTALLED

| REV. | REVISION DESCRIPTION | DATE | BY |
|---|---|---|---|
| A | INITIAL RELEASE | 08/11/00 | DJG |
| A | NEW CHAMBER "D" INSTALLATION PER ECR E-05-101 | 01/31/03 | DJG |
| B | NEW RETAINING BOILER WALL & DOCKING MANDOOR MODIFICATIONS | 03/24/04 | DJG |
| C | NEW CHAMBER "E & F" INSTALLATIONS PER ECR E-05-102 | 06/08/05 | DJG |
| D | NEW ANNEX FOR PROJECT PER ECR #E-33-001-07 | 1/28/08 | DJG |
| E | UPGRADE INCLUDING NEW PRECON "D", TRUCK DOCK ELECTRICAL AREA, ROOM NAMING | 03/31/08 | DJG |

## KEYNOTES

1. ADD NEW PARTITION WALL IN BOILER ROOM TO DIVIDE ROOM INTO SAFE ABLE WALKWAY - 1-HOUR TYPE WALL
2. MIN. 44" WIDE EXIT PATH, 4" WIDE YELLOW STRIPING @ 24" O.C. ON EXISTING FLOOR, SENCIL "EXIT ABLE-DO NOT BLOCK"
3. MOVE EXISTING OUTSIDE MANDOOR TO TOP OF STAIRCASE AND ADD PARTITION WALL TO ENCLOSE THE STRUCTURE.
4. ILLUMINATED EXIT SIGN ( NEW OR EXISTING )
5. STEEL CENTER POST @ DOOR FRAME

CAD FILE NO. - ENG\FAC\LA49\DWGS\SITE\LA49-0042

Sterigenics INTERNATIONAL, INC.

LOS ANGELES, CALIFORNIA - OVERALL PLANT LAYOUT OF 49th ST. BUILDING - PLAN VIEW

| | |
|---|---|
| PROJ. NO. - | SCALE: 1/16"=1'-0" |
| DRAWN BY: DJG DATE: 06/19/02 | DRAWING NO. LA49-0042 |
| PROJ. ENG: DATE: | |