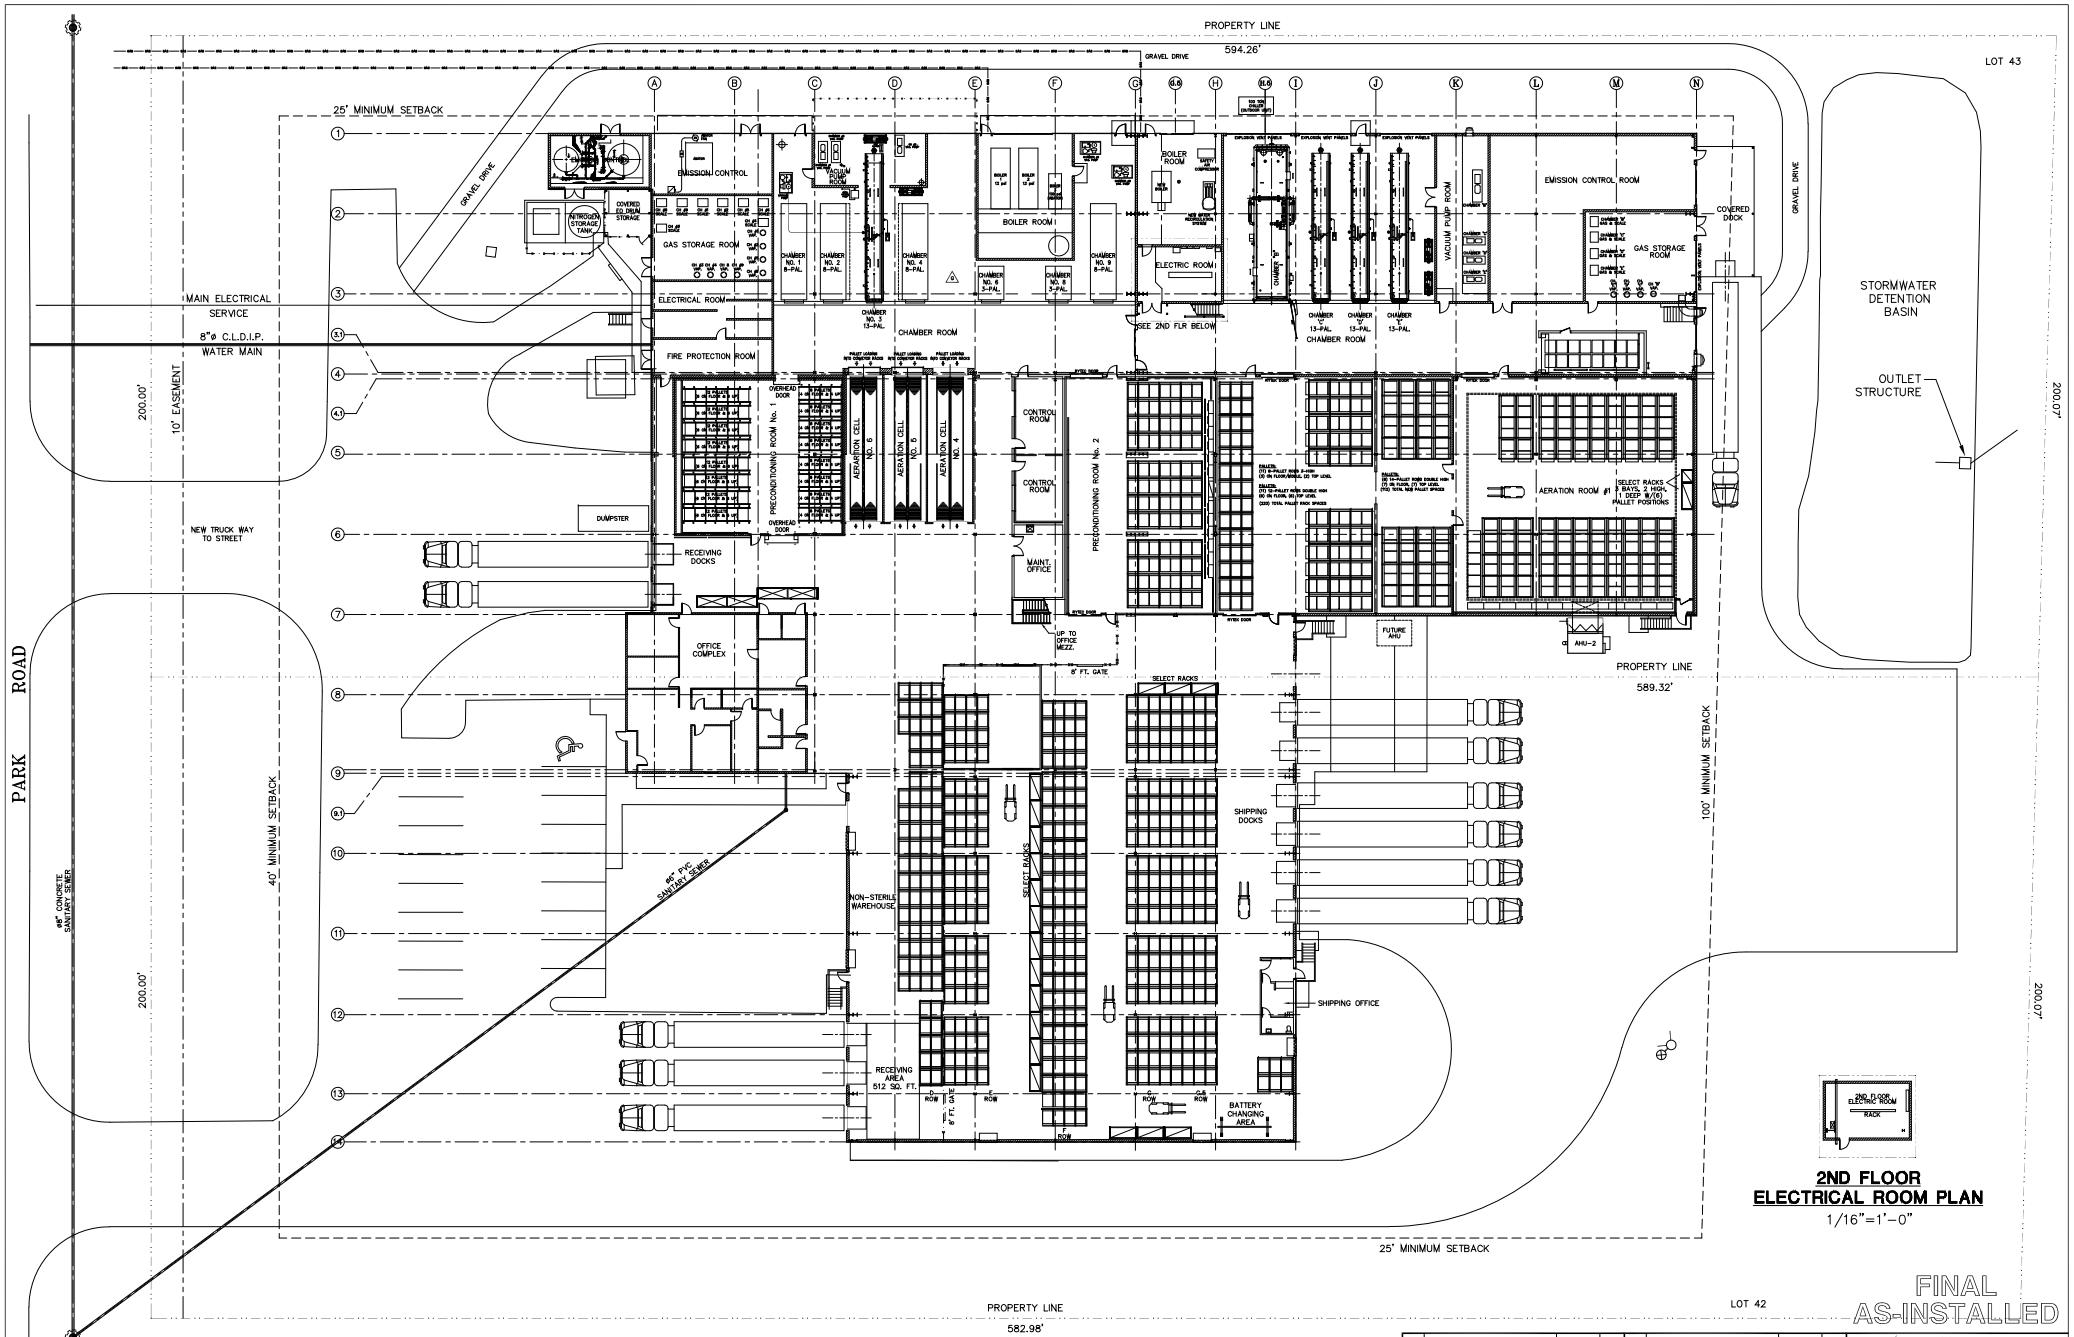

2ND FLOOR ELECTRICAL ROOM PLAN

1/16"=1'-0"

FINAL AS-INSTALLED

THIS DRAWING TO BE CONSIDERED PROPRIETARY AND CONFIDENTIAL

OVERALL BUILDING PLAN

1/16"=1'-0"

TOTAL BUILDING
75,874 SQ. FT.

DRAWING APPROVAL STAMP — Sterigenics

DIR. OF ENGINEERING _____
PROJECT ENGINEER _____
CONTRACTOR _____

REV.	REVISION DESCRIPTION	DATE	BY
0	REMOVAL OF CHAMBER No. 5	09/11/02	DJG
1	UPDATED FOR DOOR INTERLOCK & CONDENSOR SKID ADDITIONS - PER ECN E-16-003-06	03/27/07	DJG
2	NEW CHAMBER 8 AND AERATION ROOM EXPANSIONS PER ECN GF-0011	04/01/12	AK

REV.	REVISION DESCRIPTION	DATE	BY
1	ISSUED FOR REVIEW AND COMMENTS	02/03/98	LAT
2	INITIAL RELEASE FOR ECN NOS. E-18-020 & E-18-023. EXPANDED PRECONDITIONING ROOM AND ADDITION OF NEW CHAMBER NO. 3	02/20/98	LAT
3	ADDITION OF AERATION ROOM NO. 6 PER ECN NO. E-18-021	08/24/98	LAT
4	EAST & SOUTH PLANT EXPANSION INCLUDING NEW CHAMBERS 'D' & 'E', NEW AERATION ROOM, NEW PRECONDITIONING ROOM AND NEW WAREHOUSE PER ECN NO. E-18-028	07/28/99	LAT
5	ADDITION OF SELECT RACKS TO AERATION ROOM NO. 6 PER ECN NO. E-18-033	10/12/99	LAT
6	EXPANSION OF PRECONDITIONING ROOM NO. 1 PER ECN NO. E-18-035	05/12/00	LAT
7	ADDITION OF CHAMBER 'C' PER ECN NO. E-18-036	07/27/00	LAT
8	ADDITION OF 16-PALLET LOW TEMPERATURE AERATION CELL PER ECN NO. E-18-039	08/18/00	LAT

CAD FILE NO. - CF0079H4.DWG

Sterigenics

GLENS FALLS, NEW YORK
OVERALL PLANT AND EQUIPMENT LAYOUT
PLAN VIEW AND PLOT PLAN

FILE NO. 18028		SCALE 1/16"=1'-0"	
DRAWN BY LAT	DATE 02/03/98	DRAWING NO. CF-0079	
PROJ. ENG. TC	DATE 02/03/98		