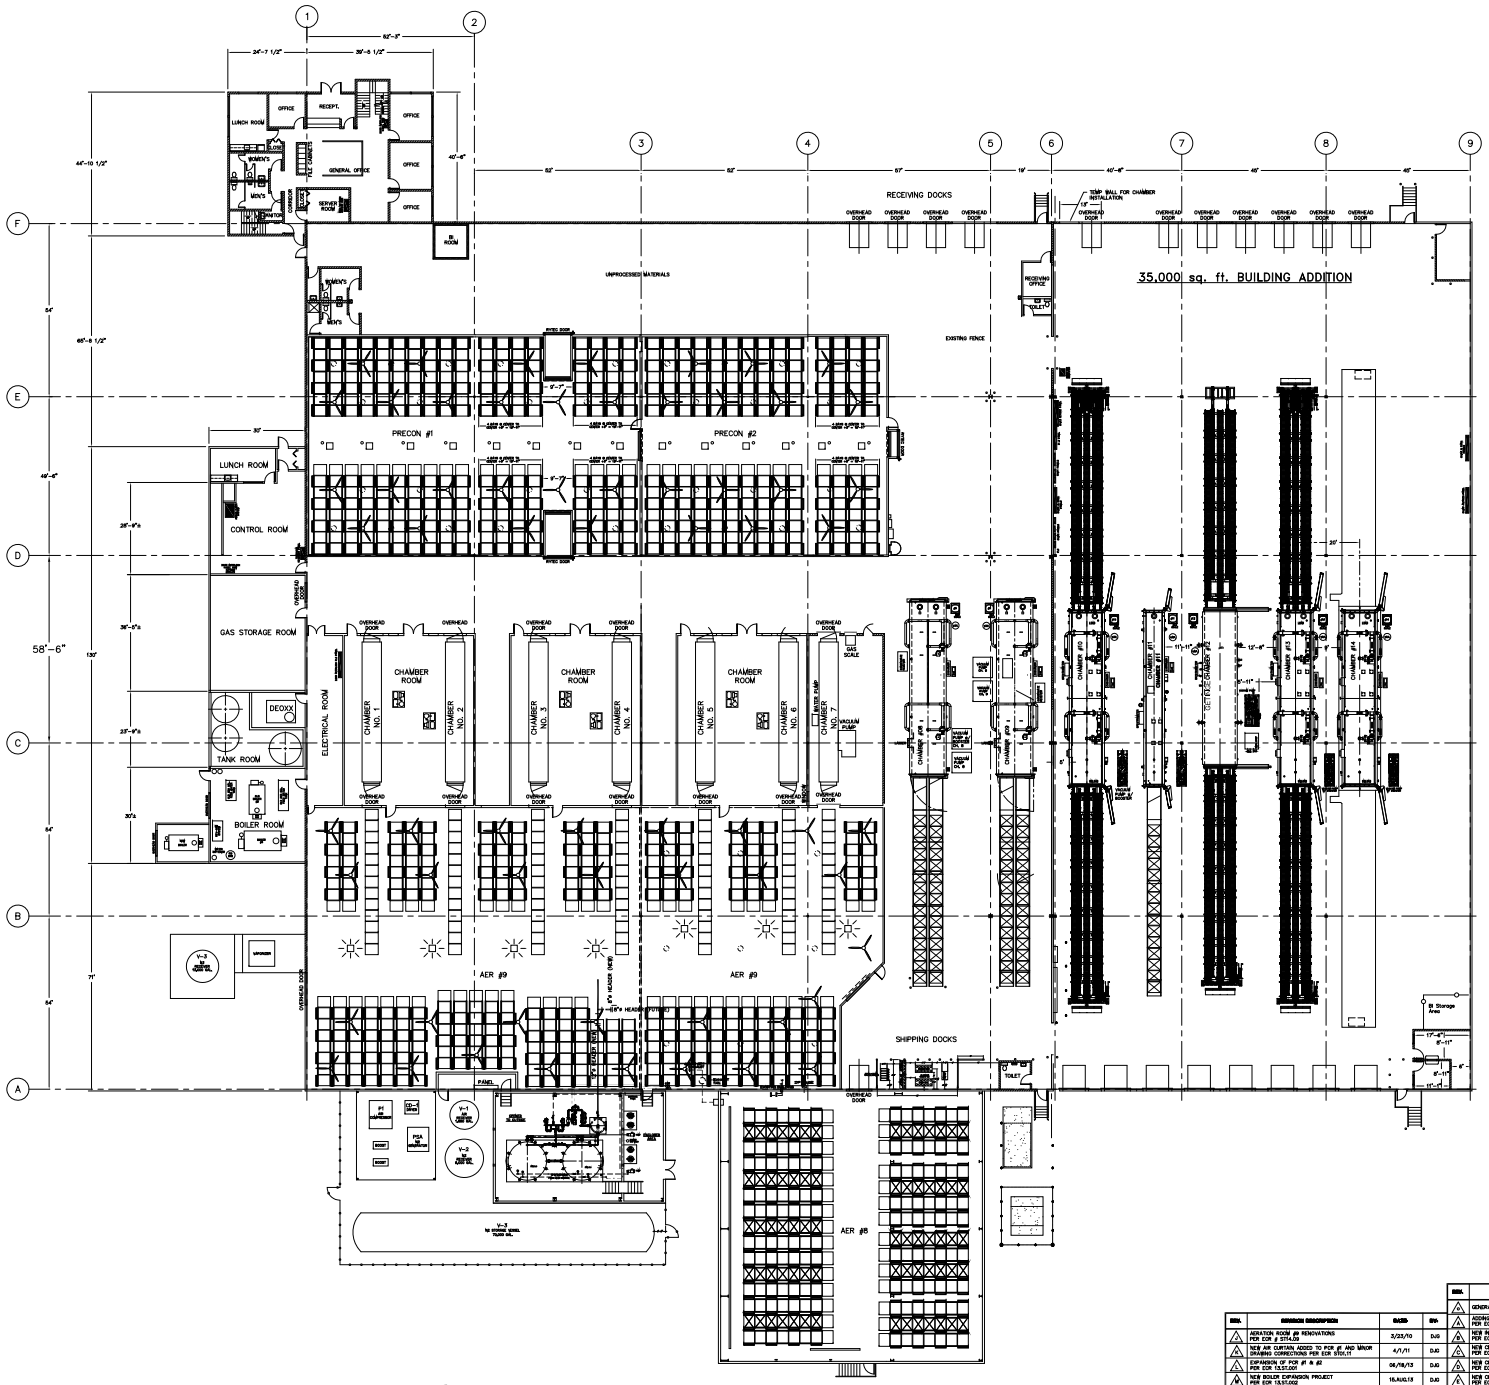

OVERALL PLANT & EQUIPMENT LAYOUT

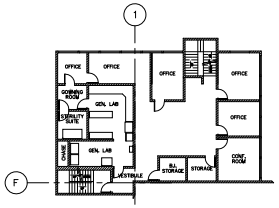

SECOND FLOOR LAYOUT

FINAL
AS-INSTALLED

REV.	REVISION DESCRIPTION	DATE	BY
A	AERATION ROOM #9 RENOVATIONS PER ECR # 2114.09	3/23/10	DJG
A	NEW AIR CURTAIN ADDED TO PCR #1 AND MINOR DRAWING CORRECTIONS PER ECR STOL11	4/1/11	DJG
A	EXPANSION OF PCR #1 & #2 PER ECR 13.ST.001	06/18/13	DJG
A	NEW BOILER EXPANSION PROJECT PER ECR 13.ST.002	16.AUG.13	DJG
A	NEW AERATION #9 ROOM RENOVATIONS/EXPANSION PER ECR 13.ST.011	23.JUN.14	DJG
A	NEW N2 SYSTEM AND PAD PER ECR 16.ST.XXX	03.MAY.2016	DJG
A	NEW CHAMBER #14 ADDITION PER ECR 19.MAR.2019	12.MAR.2019	DJG

REV.	REVISION DESCRIPTION	DATE	BY
A	GENERAL UPDATE FOR INITIAL RELEASE	08/18/00	DJG
A	ADDING ADDITIONAL CHAMBERS #8 & 9 PER ECR # E-15-069 & 071	09/30/03	DJG
A	NEW INSTALLATION OF CHAMBER #10 PER ECR # E-15-073	06/06/04	DJG
A	NEW CELCOTE SCRUBBER INSTALLATION PER ECR # E-15-075	08/09/04	DJG
A	NEW CHAMBER #11 AND AERATION ROOM PER ECR # E-30-001-06 & E-30-002-06	02/27/06	DJG
A	NEW CHAMBER #12 ADDITION AS-BUILDS PER ECR # E-30-001-07	02/20/07	DJG
A	NEW CHAMBER #13 & AERATION ROOM #8 EXP. PER ECR # E-30-002-07 & E-30-003-07	07/20/07	AK
A	NITROGEN ADDITION PER ECR STOL08	10/14/08	DJG
A	PCR ROOM #1 RENOVATIONS PER ECR # STOT.09	10/13/09	DJG
A	PCR ROOM #2 RENOVATIONS PER ECR # STOL09	01/20/10	DJG

CAD FILE - ENG\FAC\ST\DWG\SITE\ST-0026

Sterigenics

SANTA TERESA, NEW MEXICO
OVERALL PLANT & EQUIPMENT LAYOUT
PLAN VIEW

FIELD NO.	-	SCALE	1/16"=1'=0"
DRAWN BY	DJG	DATE	06/19/02
FIELD CHK	MS	DATE	10/16/02
DRAWING NO.	ST-0026		