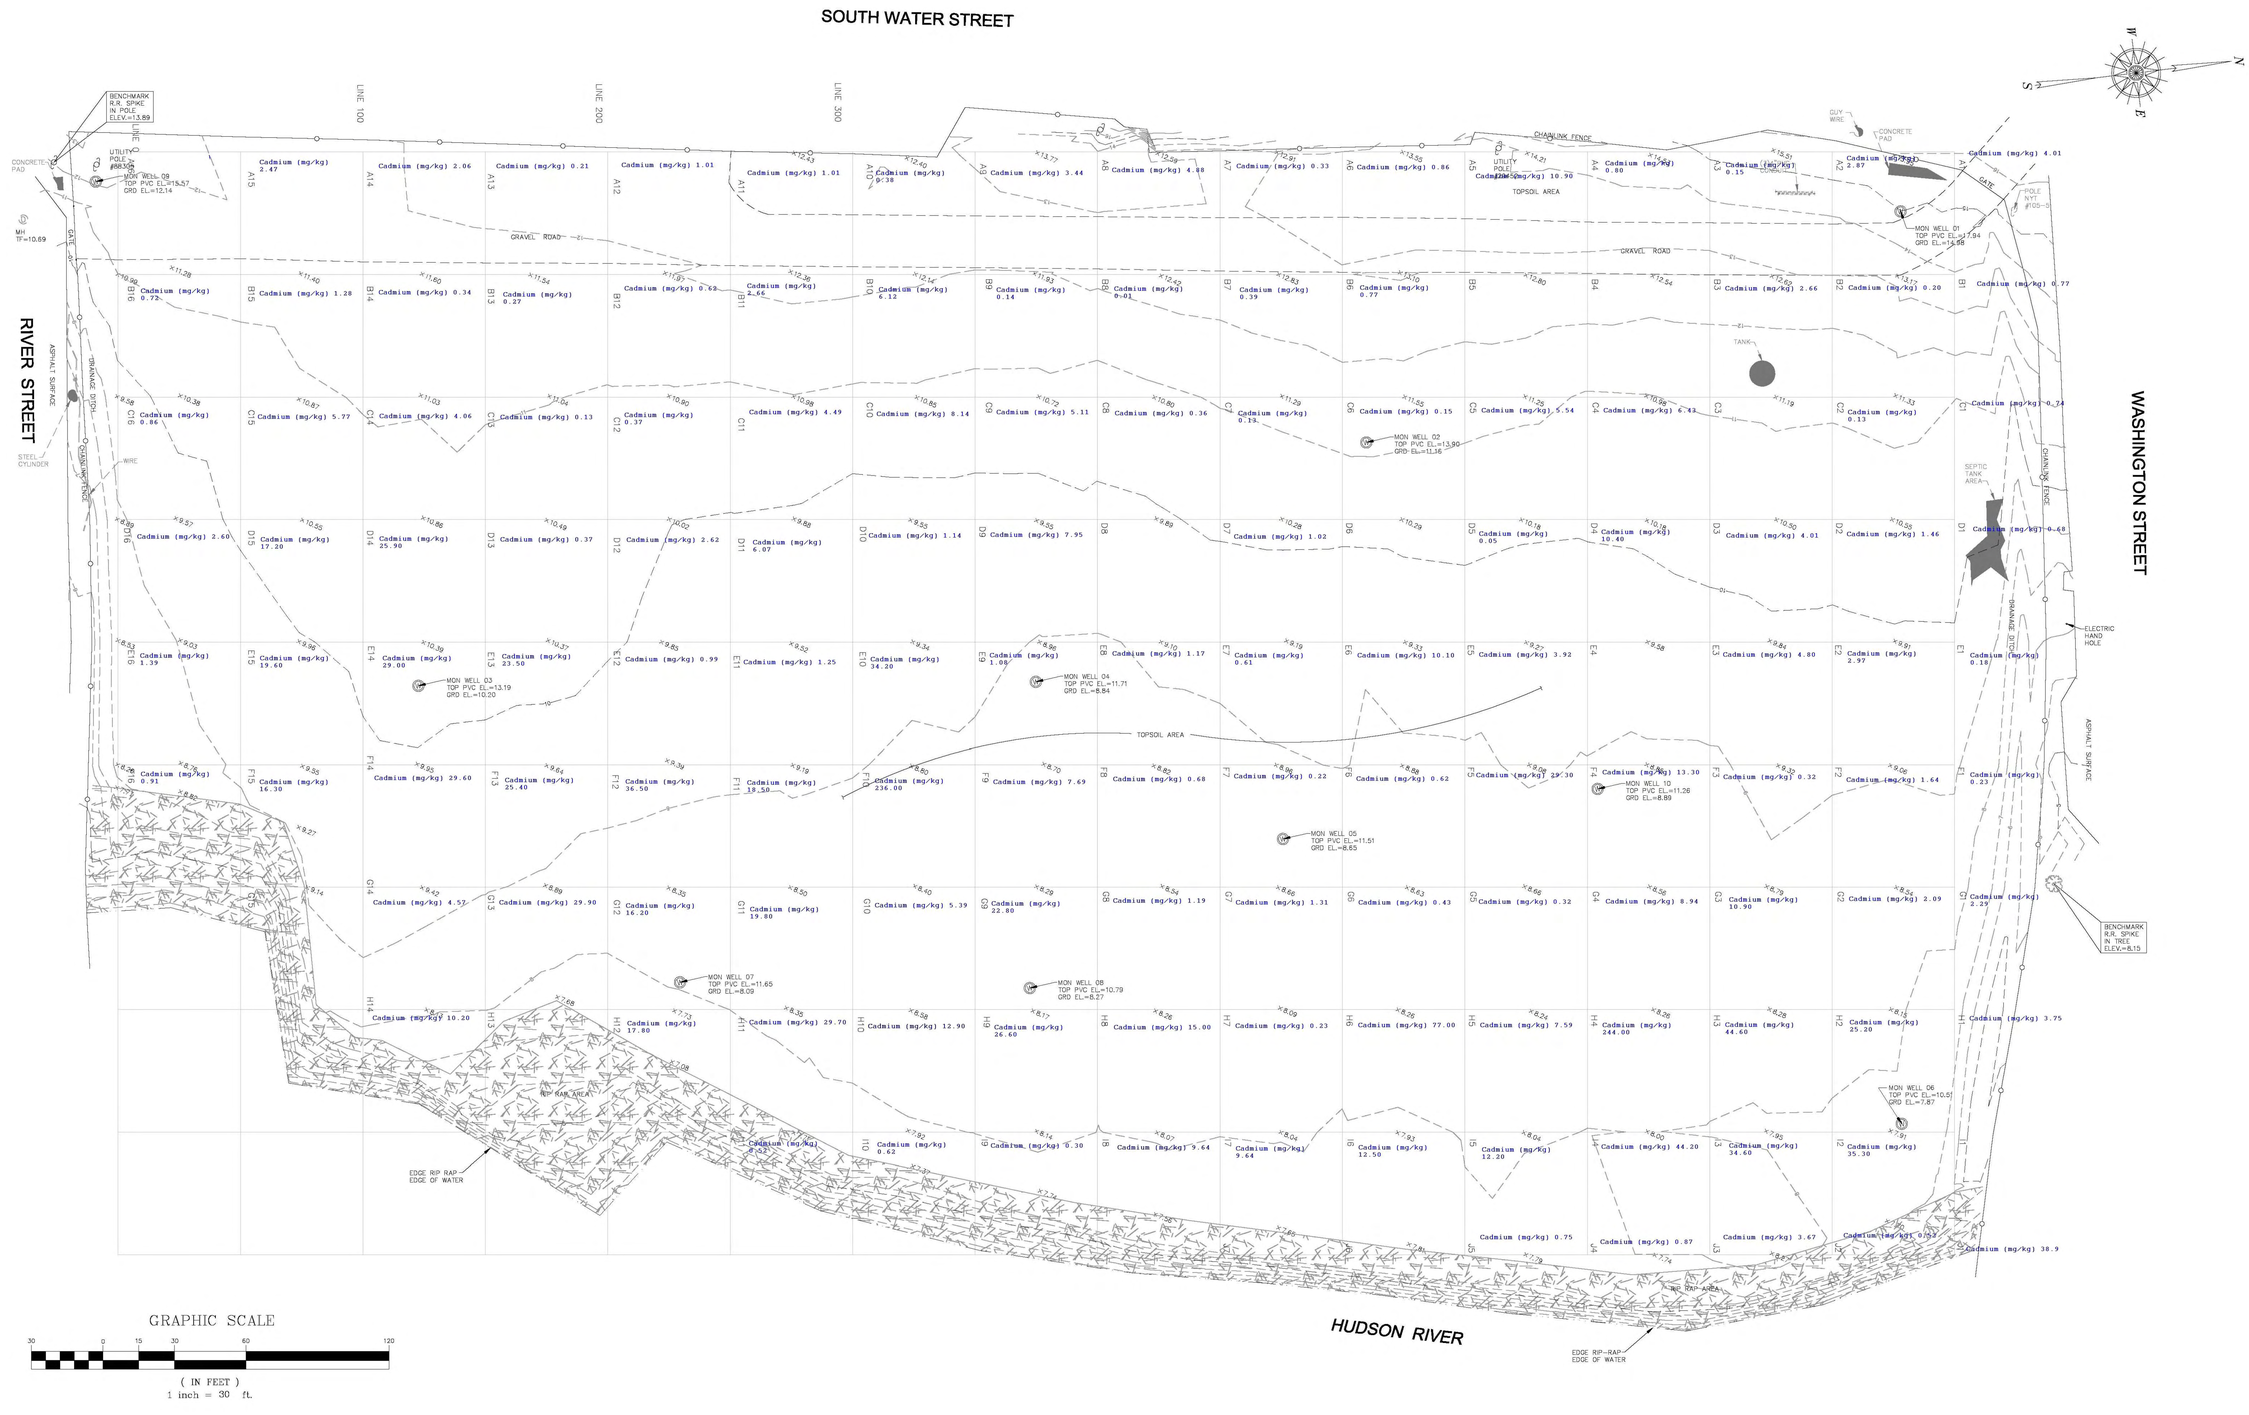

© Copyright Reserved
The Contractor shall verify and be responsible for all dimensions. DO NOT scale the drawing — any errors or omissions shall be reported to Stantec without delay.
The Copyrights to all designs and drawings are the property of Stantec. Reproduction or use for any purpose other than that authorized by Stantec is forbidden.

DATE	RECORD OF WORK	APPROVED

DRAWN BY: | FIELD SURVEY: | CHK BY: MARK R. DELOR

Stantec
3 Columbia Circle
Albany, NY
12203
Tel. 518.452.4358
Fax. 518.452.9234
www.stantec.com

Unauthorized alteration or addition to this map is a violation of section 7209, sub-division 2 of the New York State Education Law.

Only copies from the original of this map bearing an original signature and the embossed seal of the preparer shall be considered to be true and valid copies.

N.Y.S. LIC. NO. 050478

MARK R. DELOR P.L.S.

MAP SHOWING
FINAL ASBUILT PLAN
CONSOLIDATED IRON AND METAL
CITY OF NEWBURGH * ORANGE COUNTY * STATE OF NEW YORK

DATE: SEPTEMBER 1, 2010 | SCALE: 1" = 30'

Sheet No. 1 1 OF 6

Cadd

U:\194110808\drawing\Final\Final_Asbuilt-Topsoil.dwg, final-asbuilt, 9/7/2010 11:53:56 AM, gwerth, CutePDF Writer, ARCH D, 1:1